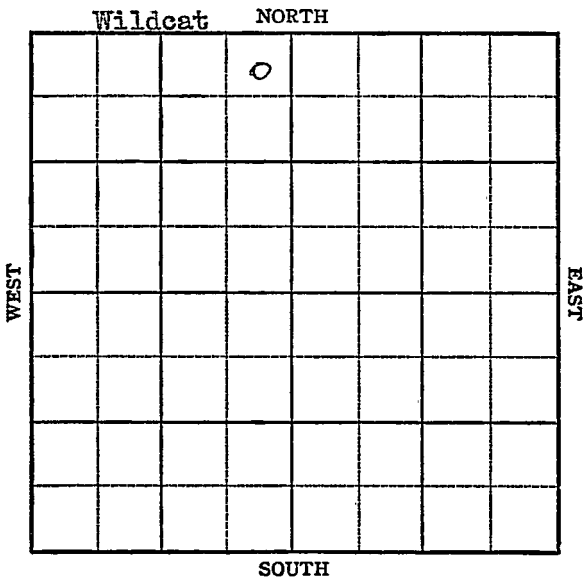


KANSASSection 6 Township 8 Range 19WWell No. 1 McCormickCompany Anderson-Prichard

KANSAS


Rooks

Sec. 6 Twp. 8 R. 19-WWell No. 1 McCormick FarmAnderson-Prichard Company

Wildcat

330 Ft. from N. Line Ft. from S. Line330 Ft. from E. Line Ft. from W. Line

NE NW

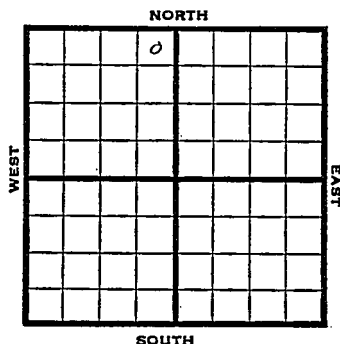

1947 Elev. 1896' REPORT

9/3 Loc.

9/10 Drlg. 929'

9/17 9" @ 1407'
Drlg. 2500'9/24 Lans. 3104'
BKC 3326'
Arb. 3368'
TD 3425'

ABANDONED

Map No. _____ Sec. 6 Twp. 8 R. 19W

Well No. 1 McCormick

Anderson-Prichard

Company

FIRST REPORT

Contractor

NE NW


SECTION PLAT

330 Ft. from N. Line

_____ Ft. from S. Line

330 Ft. from E. Line

_____ Ft. from W. Line

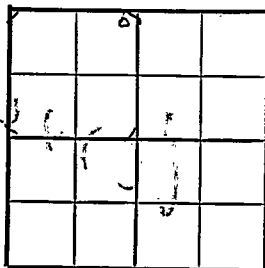

Rooks County

Location X

RECORD

Rig up _____

Drilling and Remarks:

Cased _____ in., _____ ft.

Sand _____

Gas _____

Oil _____

Total Depth _____

PRODUCTION

1st 24 hrs. Nat. _____

1st 24 hrs. after shot _____

Gas _____ Cu. Ft.

Dry Hole _____

Abandoned _____

Date

SEP 3 1947 19

S. J. LEWIS Scout

Kansas

Map No. 65 Sec. 6 Twp. 8 R. 19WWell No. 1 McCormickAnderson-Prichard Company**ABANDONED**

Contractor

NE NW

E11896
SECTION PLAT

330 Ft. from N. Line

Ft. from S. Line

330 Ft. from E. Line

Ft. from W. Line

Rooks County

Location _____

Rig up _____

Drilling and Remarks:

Lease 8104
B/K 03026.
Per 8-2868.

RECORD

Cased _____ in., _____ ft.

Sand _____

Gas _____

Oil _____

Total Depth 3425**PRODUCTION**

1st 24 hrs. Nat. _____

1st 24 hrs. after shot _____

Gas _____ Cu. Ft.

Dry Hole _____

Abandoned _____

Date

SEP 24 1947 19S. J. LEWIS Scout