


Section 6 Township 8 Range 18 W

Well No. # 1 Collins

Company E. H. Riggs

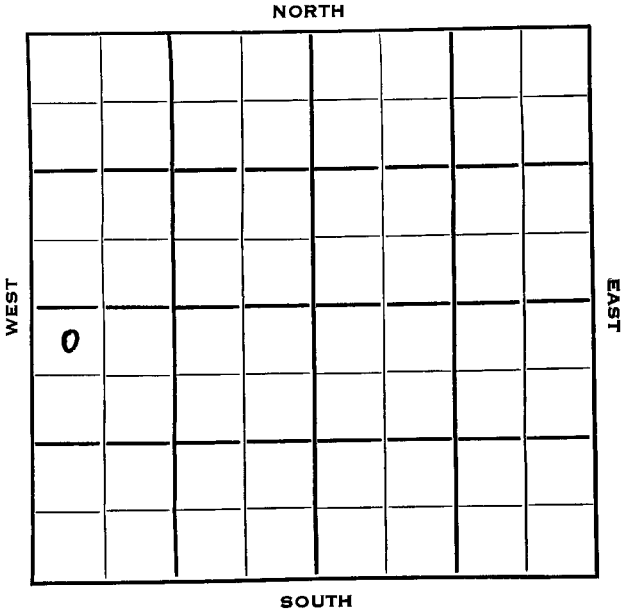

Rooks

KANSAS ✓

SEC.	TWP.	R.
6	8	18W

WELL NO.

#1 Collins

FARM

COMPANY

E. H. Riggs

CONTRACTOR


Wildcat

330 _____ Ft. from N. Line

_____ Ft. from S. Line

_____ Ft. from E. Line

330 _____ Ft. from W. Line

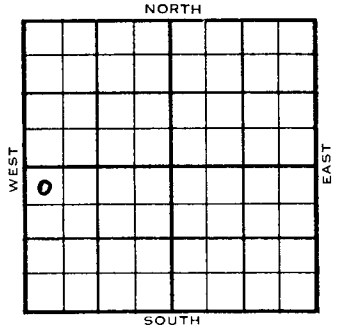

NW NW SW

Phillips - DHM

	ELEVATION	REPORT
1953	1955'	
9/9	MIR	
9/16	8" @ 156'	Heeb 3117 Tor 3142 Lans 3157' Drlg. 3170'
9/23	Spud 9-8-53 D&A TD 3520' 8" @ 156'	Heeb 3117', Tor 3142, Lans 3157, B KC 3380', Cong 3452', Arb. 3491' TD 3520' D&A
ABANDONED		

