

Section 6 Township 8 Range 25W


Well No. #1 Davis

Company Trans-Era Pet. & Nate Appleman

NORTH

WEST

EAST

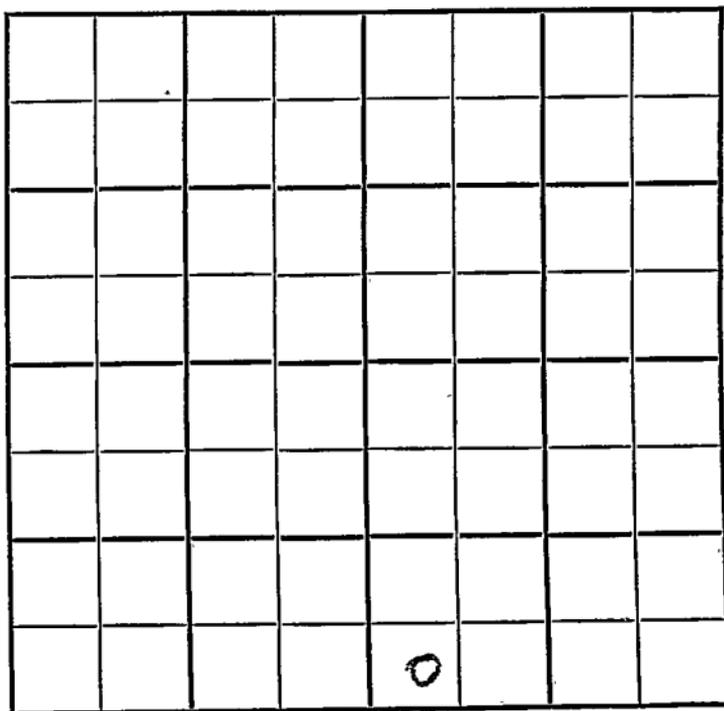

SOUTH

15

SECT.

TWP.

R.

6

8

25W

WELL NO.

1 Davis

FARM

COMPANY

Trans-Era Pet & Nate Appleman

CONTRACTOR


Co Tools
Wildcat

_____ Ft. from N. Line

330' _____ Ft. from S. Line

_____ Ft. from E. Line

330' _____ Ft. from W. Line

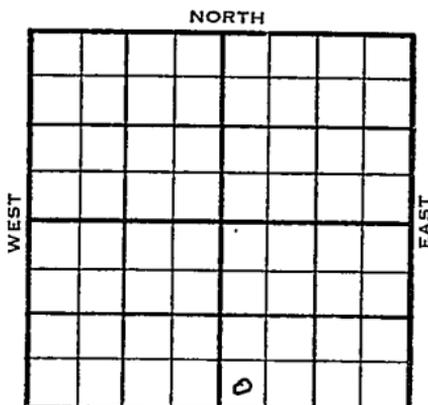

SW SW SE

(1/2 mile Sunray Mid-Continent Acreage)

1955	ELEVATION REPORT
5/25	Location
5/26	Location
6/2	Spud 5-27-55 8-5/8" @ 200 w/250 Drlg: 2920'
6/9	Heeb. 3736 Tor. 3756 Lansing 3775 DST 3792-3818, open 1 hr rec 57' mud 1125#. DST 3839-70 open 1 hr rec 210' muddy SW 1175#. Drlg. 4034'
6/15	Comm 5-27-55 8 5/8" @ 200/250 H 3736, Tr 3756, L 3775, BKC 3999, M Lm 4362, V 4447, A 4531, TD 4585 DST 3792-3818 open 1 hr Rec 57' mud 1125# DST 3839-70 open 1 hr Rec 210' muddy sw 1175# D&A

ABANDONED

County Graham Elev. 2487
 Sec. 6 Twp. 8 Rge. 25W
 Company Trans-Era Pet. & Nate Appleman
 Farm Name Davis No. 1

TOPS	DEPTH	LOG	DATUM
Anh.			
TP.			
H.	3736		1249
Tr.	3756		1269
Dg.			
BL.			
L.	3775		1288
K.C.			
B.K.G.	3999		1512
Ce.			
C.			
M.	4362		1875
M.			
K.			
Mz.			
Mq.			
V.	4447		1960
S.			
S.			
A.	4531		2044
R.			
PE.			
G.			
T.D.	4585		

Loc. in Sec. SW SW SE
 Geol. _____
 Contr. _____
 Co. tools _____
 Pool Wildcat



Date Comm. 5-27-55 **JUN 15 1955**
8 5/8" @ 200/250 -- DST 3792-3818 - open 1 hr
Rec. 57' mud 1125# DST 3839-70'
open 1 hr. Rec. 210' muddy sw 1175#
D & A

Co.
 Lse.
 No.
 Seq.
 T.
 R.