


Section 6 Township 8 Range 21WWell No. 1 GosselinCompany Fred B. Anschutz

NORTH

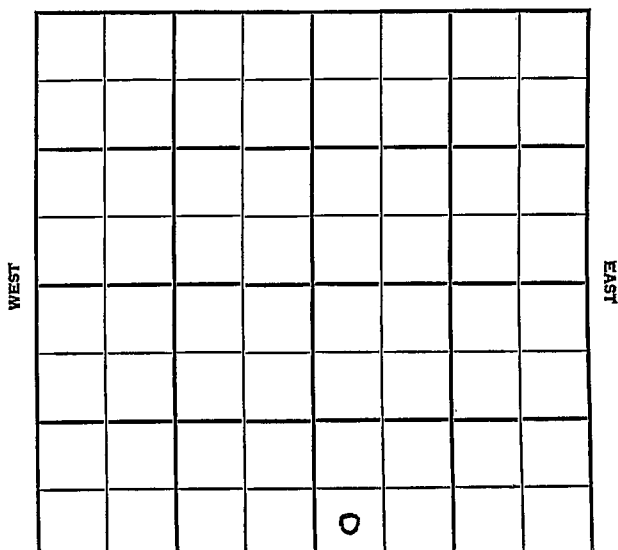

SOUTH

Graham

KANSAS

SEC.

TWP.

R.

6

8

21 W

WELL NO.

1 Gosselin

COMPANY

FARM

Fred B. Anschutz

CONTRACTOR

Co. tools

Wildcat

Ft. from N. Line

330


Ft. from S. Line

Ft. from E. Line

330

Ft. from W. Line

SW SW SE

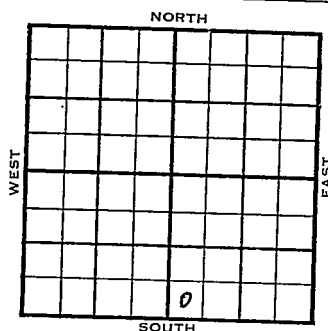

1954

ELEVATION

2115'

REPORT

10/20

Spud 10-16-54

8" @ 169

Drlg. 2050'

10/27

Spud 10-16-54 - D&A

TD 3693'

8" @ 169'

Heeb 3283', Tor 3319', Lans 3334'

DST 3368-87', opn 45", rec. 25' mud, 880#

DST 3494-3525', opn 45", rec. 65' mud, 1080#

B KC 3540', Cong 3602', Arb. 3643'


DST 3643-51', opn 1/2 hrs., rec. 5' mud, 690#

TD 3693'

D&A

ABANDONED

County Graham State Kansas
Sec. 6 (Blk. 8) (Sur. 21W) Map No. 1
Operator Fred B. Anschutz
Well No. 1 Farm Gosselin
Elev. _____ Location SW SW SE

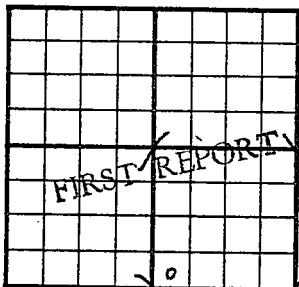

330 Ft. From S Line SE
330 Ft. From W Line Quarter
1st. Report OCT 20 1954

Completion _____

Remarks _____

Co. tools

Spudding Date 10-16-54


Drlg. Data _____

Wildcat

8" @ 169 drlg. 2050

FABEN GILSTRAP

County Graham State Kansas
 Sec. 6 (Blk.) 8 (Sur.) 21W Map No.
 Operator Fred B. Anschutz
 Well No. 1 Farm Gosselin
 Elev. 2115 Location SW SW SE

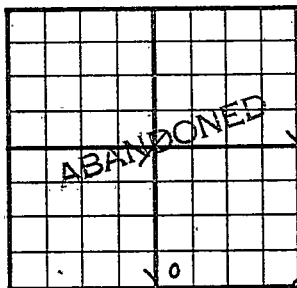

330 Ft. From S Line SE
330 Ft. From W Line Quarter

1st. Report

Completion OCT 27 1954

Remarks Wildcat
Co. tools

Spudding Date 10-16-54

Drilg. Data D & A TD 3693

8" @ 169 Heeb. 3283 Tor. 3319

Lans. 3334 DST 3368-87 open 45 min.

Rec. 25' mud 880# DST 3494-3525

open 45 min. Rec. 65' mud 1080#

B KC 3540 Cong. 3602 Arb. 3643

DST 3643-51 open $\frac{1}{2}$ hr. Rec. 5' mud

690# TD 3693

D & A

FABEN GILSTRAP