
FORM 51

Rooks KANSAS

Section 7 Township 8 Range 17 W

Well No. # 1 Hrabe

Company ~~Murfin Drlg. & Morris Sitrin~~

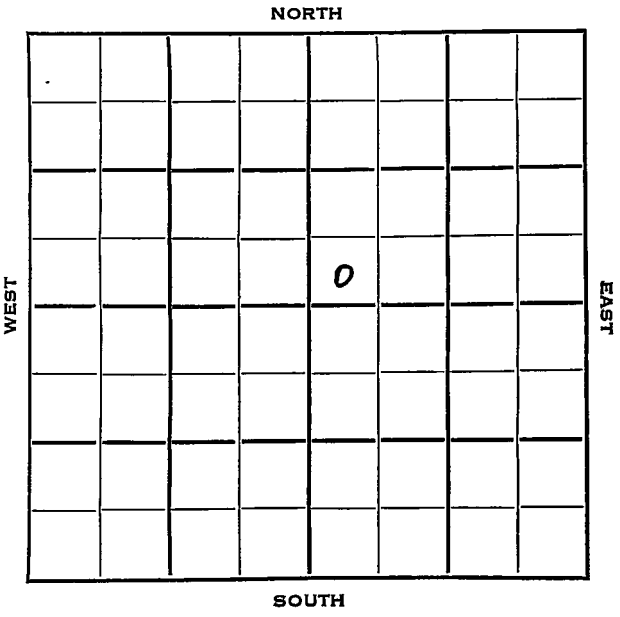

FORM 252-B
10M 10-50 PETROL

Rooks KANSAS

Sec. 7 Twp. 8 R. 17W

Well No. #1 Hrabe Farm

Murfin Drlg. & Morris Sitrin Company

Murfin Drlg. Contractor


Wildcat.

Ft. from N. Line

330 Ft. from S. Line

Ft. from E. Line

330 Ft. from W. Line

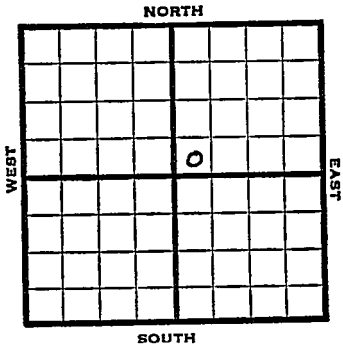

SW SW NE

CSO-DHM

1953	Elev. 1944' REPORT
6/9	Spud 6-5-53 8" @ 160' Anhy 1327' Drlg 2645'.
6/24	Spud 6-5-53 D & A TD 3432 8" @ 160 Anhy 1327 Top 2866 Heeb 3077 Tor 3101 Lans 3121 DST 3395-3410 open ½ hr rec 30' OCM 500# Arb. 3406 TD 3410 5" @ 3408 TD 3432 D & A **ABANDONED**

FORM 275 FOR SALE BY KANSAS BLUE PRINT CO.

County Rooks State Kansas

Sec. 7 (Blk. Twp.) 8 (Sur. Rge.) 17W Map No.

Operator Murfin Drlg. & Morris Sitrin

Well No. 1 Farm Hrabe

Elev. Location SW SW NE

330 Ft. From S Line NE

330 Ft. From W Line Quarter

FIRST REPORT

1st. Report JUN 1 0 1953

Completion

Remarks CSO - DHM

Murfin Drlg. - Contr.

Spudding Date 6-5-53

Drlg. Data Wildcat

8" @ 160 Anhy 1327 drlg. 2645

J. G. McGEHEE

FORM 275 FOR SALE BY KANSAS BLUE PRINT CO.


County Rooks State Kansas

Sec. 7 (Blk. Twp.) 8 (Sur. Rge.) 17W Map No.

Operator Murfin Drlg. & Morris Sitrin

Well No. 1 Farm Hrabe

Elev. 1944 Location SW SW NE

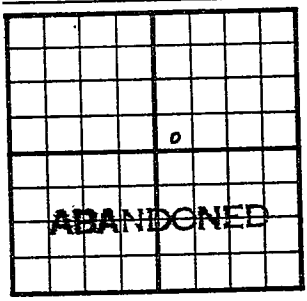

330 Ft. From S Line NE

330 Ft. From W Line Quarter

1st. Report

Completion JUN 24 1953

Remarks Wildcat

Murfin Drlg. - Contr.

Spudding Date 6-5-53

Drlg. Data D & A TD 3432

8" @ 160 Anhy 1327 Top. 2866

Heeb. 3077 Tor. 3101 Lans. 3121

DST 3395-3410 open ½ hr. Rec. 30' ocm

500# Arb. 3406 TD 3410 5" @ 3408

TD 3432

D & A

J. G. McGEHEE