

KANSAS


FORM 51 5M BRIA

Sheridan

Section 7 Township 8 Range 26W

Well No. #1 Flagler

Company Derby Oil

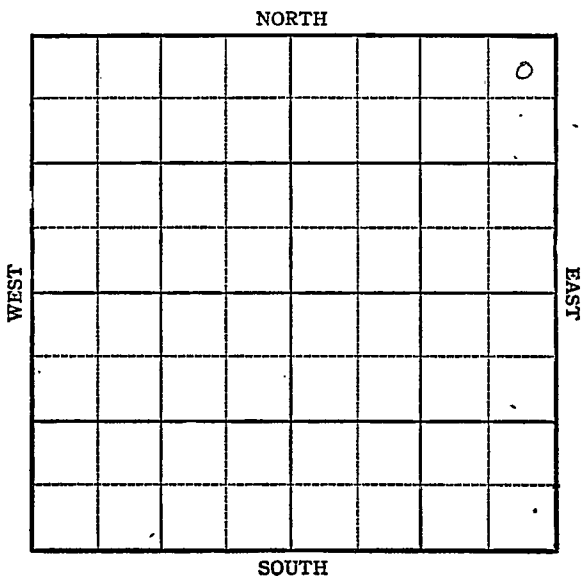

KANSAS

Sheridan

Sec. 7 Twp. 8 R. 26W

Well No. #1, Flagler Farm

Derby Oil Company

Wildcat


330 Ft. from N. Line

 Ft. from S. Line

330 Ft. from E. Line

 Ft. from W. Line

Elev. 2571

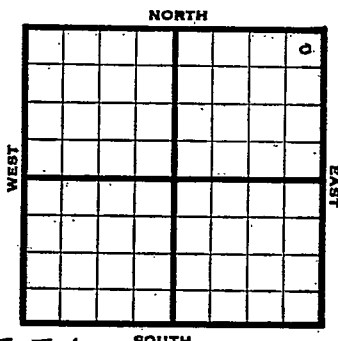

1944

REPORT

6/14 Location

6/21 8" @ 306 WOC

6/28 Drlg 3304

7/12 BKC 4032
Miss 4749
Arb 4812
TD 4870

ABANDONED

Pool Name WildcatMap No. KANSAS Sec. 7 Twp. 8 R. 26WWell No. 1 FlaglerDerby Oil


Company

ABANDONED

Contractor

NE/C

SECTION FLAT

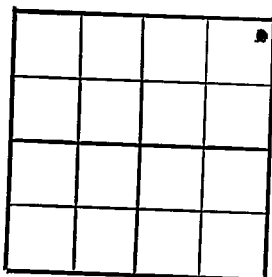330 Ft. from N. Line Ft. from S. Line330 Ft. from E. Line Ft. from W. LineSheridan CountyLocation Rig up

Drilling and Remarks:

BIT C 4032Misc 4749CR 4812

RECORD

Cased in, ft.Sand Gas Oil Total Depth 4870

PRODUCTION

1st 24 hrs. Nat. 1st 24 hrs. after shot Gas Cu. Ft.Dry Hole Abandoned

Date

JUL 1 2 1944

19.

S. J. LEWIS

Scout


KANSASPool Name WildcatMap No. 67 Sec. 7 Twp. 8 R. 26WWell No. 1 FlaglerDerby Oil

Company

FIRST REPORT

Contractor

NE/C

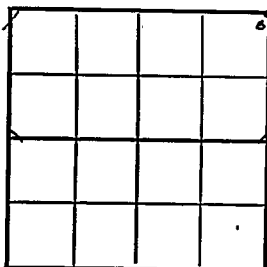SECTION PLAT330 Ft. from N. Line Ft. from S. Line330 Ft. from E. Line Ft. from W. LineSheridan CountyLocation XRig up

Drilling and Remarks:

RECORDCased in., ft.Sand Gas Oil Total Depth **PRODUCTION**1st 24 hrs. Nat. 1st 24 hrs. after shot Gas Cu. Ft.Dry Hole Abandoned

Date

JUN 14 1944 19S. J. LEWIS

Scout