


Section 7 Township 8 Range 24W

Well No. 1 ~~Fox Est.~~ Hoddard

Company Berwick et al

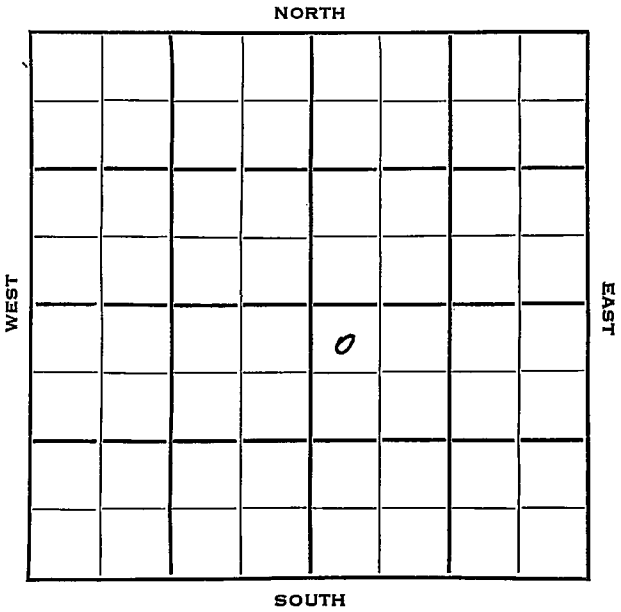

10

Graham

SEC. 7 TWP. 8 R. 21W <sup>17</sup> KANSAS ✓

WELL NO. #1 ~~Fox~~ <sup>Goddard</sup> Est. FARM

COMPANY Berwick et al

CONTRACTOR Berwick Wildcat

330


Ft. from N. Line

Ft. from S. Line

Ft. from E. Line

330

Ft. from W. Line

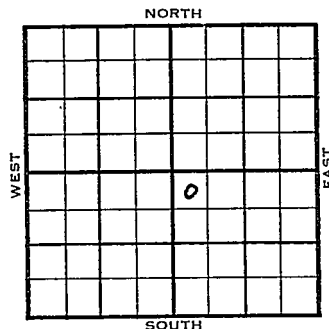

NW NW SE

1953 ELEVATION 2363' REPORT

10/28 Spud 10-27-53  
10" @ 130'

11/4 D<sub>r</sub>lg. 3502'

11/11 NR

11/18 Spud 10-27-53

D & A

TD 4247'

10" @ 130'

Heeb 3667' Lans 3708' B KC 3927'

Cong 4215'

TD 4247'

D & A

**ABANDONED**

Kansas

Map No. \_\_\_\_\_ Sec. 7 Twp. 8 R. 24W

Well No. 1 Goddard

Berwick etal.

Company

**CORRECTION**

Contractor

NW NW SE

SECTION PLAT

330 Ft. from N. Line

\_\_\_\_\_ Ft. from S. Line

\_\_\_\_\_ Ft. from E. Line

330 Ft. from W. Line

		0	

Graham County

RECORD

Location \_\_\_\_\_

Cased \_\_\_\_\_ in., \_\_\_\_\_ ft.

Rig up \_\_\_\_\_

Sand \_\_\_\_\_

Drilling and Remarks:

Gas \_\_\_\_\_

Reported  
#1 Fox Est.

Oil \_\_\_\_\_

Total Depth \_\_\_\_\_

PRODUCTION

1st 24 hrs. Nat. \_\_\_\_\_

1st 24 hrs. after shot \_\_\_\_\_

Gas \_\_\_\_\_ Cu. Ft.

Dry Hole \_\_\_\_\_

Abandoned \_\_\_\_\_

Date

NOV 4 1953

J. G. McGEHFF Scout



