
Graham KANSAS

SECTION 7 TOWNSHIP 8 S RANGE 22 W

WELL NO. # 1 Stuchlik

COMPANY K & E BOA

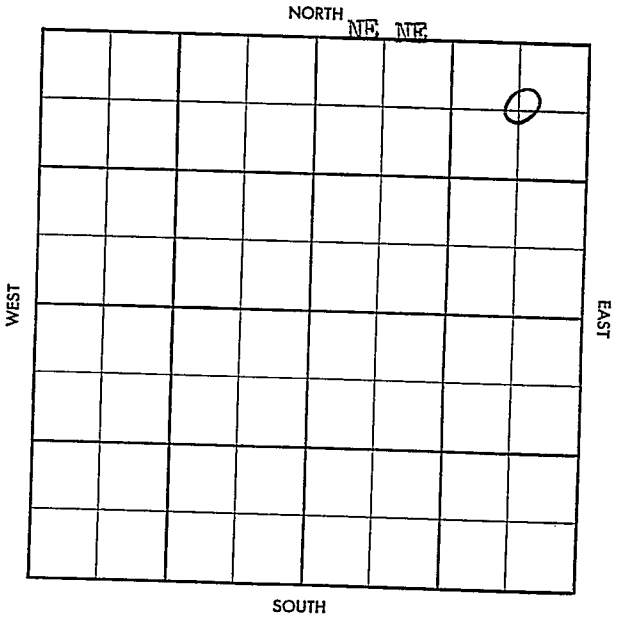

FORM 504-S SUNRAY

S-513-B

County Graham Elev.

Sec. 7 Twp. 8 Rge. 22W

Company K & E BOA

Farm Name Stuchlik No. 1

TOPS	DEPTH	LOG	DATUM
Anh.			
Tp.			
H.			
Tr.			
Dg.			
B.L.			
L.			
K.C.			
B.K.C.			
Ce.			
C.			
M.			
M.			
K.			
Mz.			
Mq.			
V.			
S.			
S.			
A.			
R.			
Pf.			
G.			
T.D.			

Loc. in Sec. NE NE

Geol.

Contr. Co. Tools

Pool

JUL 23 '58

FIRST REPORT

Date Comm.

Location

Co. Lse. No. Sec. T. R.

Twp. 11S Pool 11

Co. Facet 12

CORRECTION 5

S–513-B

County Graham Elev. 2186 RB 2183 DF

Sec. 7 Twp. 8 Rge. 22W

Company K & E bCA

Farm Name Stuchlik No. 1

TOPS	DEPTH	LOG	DATUM
Anh.			
Tp.			
H.	3390		
Tr.			
Dg.			
B. L.			
L.	3428		
K.C.			
B.K.C.			
Ce.			
C.			
M.			
M.			
K.			
Mz.			
Mq.			
V.			
S.			
S.			
A.			
R.			
Pf.			
G.			
T.D.	3660		

Loc. in Sec. C NE NE

Geol.

Contr. Co. Tools

Pool ~~Lans~~ Harmony 50 Disc

COMPLETE

SEP 3 '58

Date Comm. 7-23-58 8:250

Location AUG 30 '58 DST 3419-45 30" 30 50 6 gcm BHP 370 DST 3450-70 90" 2360' SW ~~FP~~ FP BHP 1210 DST 3488-3511 90" 120' gip 75 0 6 gcm 60 HO+gcm 120 VHO 6 gcm 180 VHO 6 gcm 60 50 6 gcm 70 W FP 30-270 BHP 1110-1060 DST 3544-75 1hr 690 gip

FORM 513-1 SUNRAY

150' gcm 75' VHO & gcm 210'
MD 100' oil FP 30-70 BHP
1320-1210 ϕ 3575
AUG 6 '58 DST 3571-3604 90" 9/17"
F10 wi 48" est 10-15 BOPH
Gr 42° B.HP. 1350 DST 3600-60
60" 120' gip 240' SOCMW 180'
SOWM 120' OCMW 190' W
BHP 1240/20 log 4½ 3659/125
CO 32/3579-86 Flo 11 BOPH
NW 6 hrs ~~test~~ AUG 13 '58 AUG 20 '58
AUG 27 '58 ~~Flo~~ SEP 3 '58
Phy Flo 240 BO NW pd
Gr 42.5°
Lsg

7-8-22W ne ne nw