

# KANSAS

FORM 51 5M 4-41 PETROL

Graham

Section 7 Township 8 Range 23-W

Well No. #1 Montgomery

Company Cities Service Oil

|  |  |  |   |  |  |  |  |
|--|--|--|---|--|--|--|--|
|  |  |  |   |  |  |  |  |
|  |  |  |   |  |  |  |  |
|  |  |  |   |  |  |  |  |
|  |  |  | 0 |  |  |  |  |
|  |  |  |   |  |  |  |  |
|  |  |  |   |  |  |  |  |
|  |  |  |   |  |  |  |  |
|  |  |  |   |  |  |  |  |

NORTH

WEST

EAST

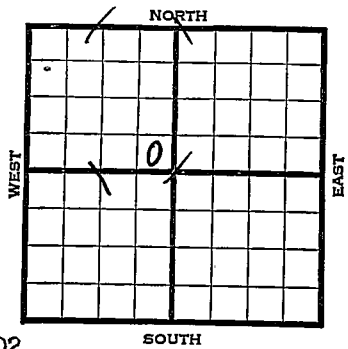
SOUTH

6

Sec. 7 Twp. 8 R. 23-WWell No. #1 Montgomery FarmCities Service Oil

Company

(Wildcat)

       Ft. from N. Line330 Ft. from S. Line330 Ft. from E. Line       Ft. from W. Line

Elev. 2302

1941

REPORT

7/1

Location

7/10

"

7/17

"

7/24

"

7/31

"

8/7

"

8/15

"

8/21

"

8/28

"

9/4

Drlg. 300'

9/11

8" - 310' Drlg. 3191'

9/18

B. Ft. Hays 4600 Morrison 1322'

Anhy. 1970' Ft. Riley 2660'

Lans. 3550' Arb. ????

T.D. 4018' No shows.

4" - 3825' RUST.

9/25

41 shots 3725-32'

60 " 3744-55½' 1900' oil 4

hours.

10/2

5000 acid. Swab 7½ bbls. oil

per hour, 850' off bottom.

10/9

" " " " OVER

1941

10/16 Swab 95 fluid in 9 hours,  
40% water.

10/23 " "

10/30 Shut down.

11/6 " "

11/13 " "

11/19 Arb. 3980'

4" - 3825'

Lans. 3550'

T.D. 4018'

101 shots 3725-55 $\frac{1}{2}$ '

5000 acid.

Pump 71 oil & 71 water.

38.7 Gravity

COMPLETED

Map No. 66 Sec. 7 Twp. 8 R. 23WWell No. 1 MontgomeryCities Service Oil Company~~FIRST REPORT~~ Contractor

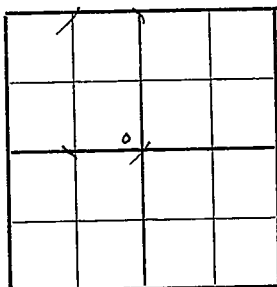
SE NW

Ft. from N. Line

330 Ft. from S. Line330 Ft. from E. Line

Ft. from W. Line

## SECTION PLAT



WILDCAT

Location X

Rig up

Drilling and Remarks:

## RECORD

Cased          in.,          ft.Sand                                 Gas                                 Oil                                 Total Depth                                 

## PRODUCTION

1st 24 hrs. Nat.                                 1st 24 hrs. after shot                                 Gas                                  Cu. Ft.Dry Hole                                 Abandoned                                 

Date

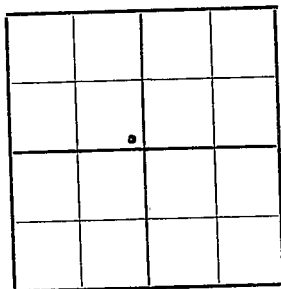
JUL 1 1941 19 S. J. LEWIS Scout

Map No. T-66 Sec. 7 Twp. 8 R. 23NWell No. 1 MontgomeryCities Service Oil Company**COMPLETED**

Contractor

SE NW

## SECTION PLAT

       Ft. from N. Line330 Ft. from S. Line330 Ft. from E. Line       Ft. from W. Line

WILDCAT

Location                                 Rig up                                 

Drilling and Remarks:

*Cr 8978  
4" @ 3825.**Loss 3500**101 x hr to 8725 - 55 1/2**5000 rods**Pump 71 oil & 71 water**382 gr*

## RECORD

Cased        in.,        ft.Sand                                 Gas                                 Oil                                 Total Depth 4018

## PRODUCTION

1st 24 hrs. Nat.                                 1st 24 hrs. after shot                                 Gas                                  Cu. Ft.Dry Hole                                 Abandoned                                 

Date

NOV 19 1941

19

S. J. LEWIS

Scout