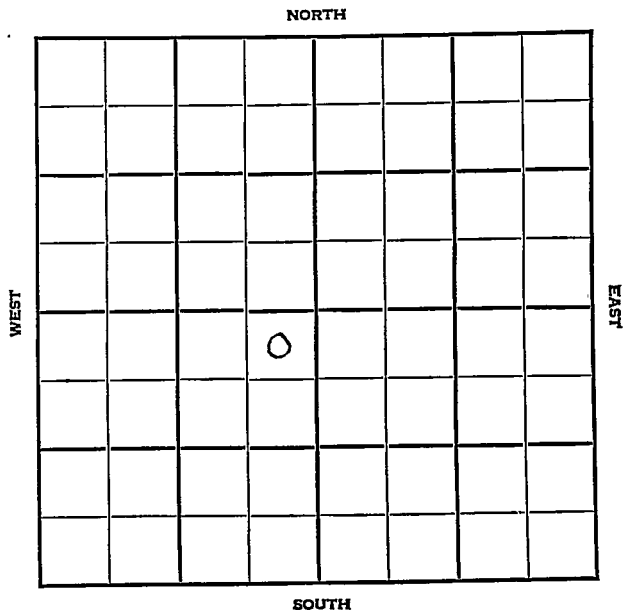


KANSAS Graham

Section 7 Township 8 Range 23WWell No. 1 Emery "B"Company Cities Service

KANSAS Graham ✓

Sec. 7 Twp. 8 R. 23-W

Well No. #1 Emery "B" Farm

Cities Service

Wildcat

Company


330 Ft. from N. Line

Ft. from S. Line

330 Ft. from E. Line

Ft. from W. Line

NE SW

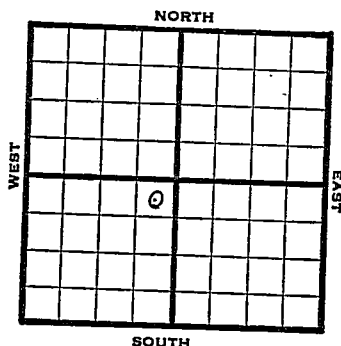

1948

Elev. 2294'

REPORT

8/4

Location

8/11

8" @ 304'

8/18

Drlg 2785'

Drlg 3705'

8/25

Topeka 3165

Lansing 3549'

BKG 3782'

Arb. 3959'

TD 3985'

5" @ 3820'

9/1

"

9/8

"

9/14

SLM 3985-91'

Lansing 3555'

Arbuckle 3965'

5" @ 3826'

24 shots 3744-51

9 shots 3740-48

13 shots 3718-80

24 shots 3725-34 2000 acid

3740-51 2000 acid 3718-24

Pump 138 W in 7 hrs.

9/21

Squeeze all perf

9/29

43 shots 3740-51 2000 acid

Pump 48 bbls oil / 6 W 18 hrs.

56 shots 3716-30-2000 Acid

Pump 245 bbls oil / 14 W 24 hrs.

10/6

"

10/13

"

10/19

"

OVER

1948
10/26

43 shots 3740-51 2000 acid
Pump 48 bbls oil / 6 W 18 hrs. 56 shot
3716-30 2000 acid
Pump 245 bbls oil / 14 W 24 hrs.

11/3

"

11/10

"

11/17

Lansing 3555'
Arb 3965'
5" @ 3826'
Perf Lans.
2000 acid
Pump 190 oil & 3.W Pot.
Gr. 28°
TD 3991'

COMPLETED

Graham County Kansas State

Map No. _____ Sec. 7 Twp. 8 R. 23W


Well No. 1 Emery "B"

Cities Service Company

FIRST REPORT Contractor

NE SW

SECTION PLAT

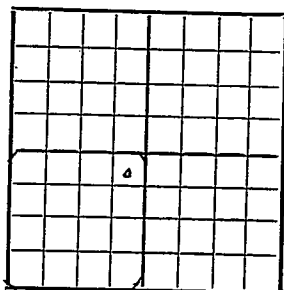

330 Ft. from N. Line

_____ Ft. from S. Line

330 Ft. from E. Line

_____ Ft. from W. Line

Wildcat

Remarks: _____

Location

Date

AUG 4 1948

Scout

S. J. LEWIS

Kansas

Map No. 66 Sec. 7 Twp. 8 R. 23WWell No. 1 Emery "B"

Cities Service

Company


COMPLETE

Contractor

NE SW

E1, 2294

SECTION PLAT

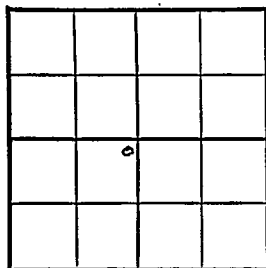330 Ft. from N. Line

Ft. from S. Line

330 Ft. from E. Line

Ft. from W. Line

Graham County

Location

Rig up

Drilling and Remarks:

Line 3555Cr 39655' C 3826Perf 4 in.2000 acidPump 190 oil 73WBot 280 ft

RECORD

Cased _____ in., _____ ft.

Sand _____

Gas _____

Oil ☒Total Depth 3791

PRODUCTION

1st 24 hrs. Nat. _____

1st 24 hrs. after shot _____

Gas _____ Cu. Ft.

Dry Hole _____

Abandoned _____

Date

NOV 17 1948

19

S. J. LEWIS

Scout