


Section 7 Township 8 Range ~~26W~~ 27W
Well No. #1 Toothaker
Company Leben Drlg.

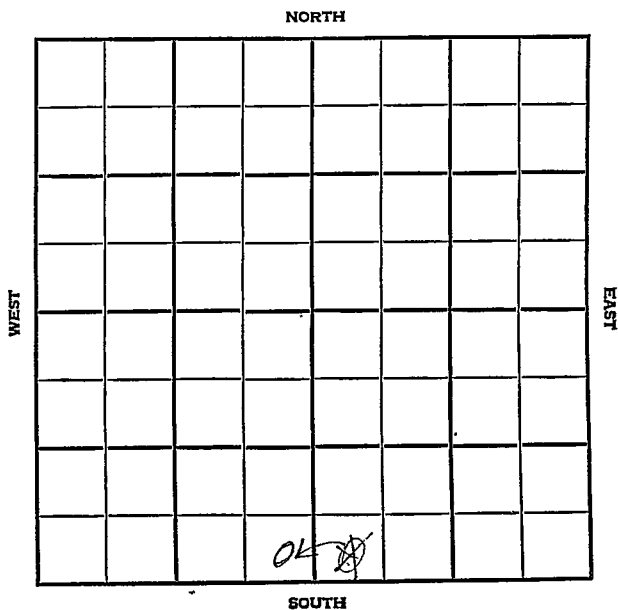

County Sheridan Elev. _____
 Sec. 7 Twp. 8 Rge. 26W
 Company Leben Drlg.
 FarmName Toothaker No. 1

TOPS	DEPTH	LOG	DATUM	Loc. in Sec.
Anh.				SW SW SE
Tr.				
H.				
Tr.				
Dg.				
Bl.				
L.				Geol.
K.C.				Contr.
B.K.C.				
Ce.				
C.				
M.				Pool
M.				
K.				
Mz.				
Mo.				
V.				
S.				
S.				
A				
R.				
Pe.				
G.				
T.D.				

FIRST REPORT
 NOV 14 58

Date Comm. Carter & CSO - DHM
spudding

2201 5.5 VGM

CORRECTION

FORM 413 SUNRAY

County Sheridan Elev. 2662 DE
 Sec. 7 Twp. 8 Rge. 26W 27W
 Company Leben Brlg.
 Farm Name Toothaker No. 1

TOPS	DEPTH	LOG	DATUM	Loc. in Sec.
Ank.	12350			SW SW SE SE SE SW
Tp.	2637			
H.	3823			
Tr.	3852			
Dg.				
BE.				
L.	3870			Geol.
K.C.				Contr. <u>Kan-Tex</u>
B.K.C.	4088			
Ce.	4300			
C.				
M.	4427			Pool
N.				
K.				
Mz.				
Ma.				
V.				
S.				
S.				
A.				
R.				
PE.				
G.				
TD.	4480			

ABANDONED

NOV 29 '56

OK

Date Comm. Carter & CSD - DHM

spudding NOV 21 '56 11-13-56

8 5/8 229 1185 10 3655 NOV 28 '56

DEA