


Section 7 Township 8 Range 28 W

Well No. # 1 James

Company Cities Service

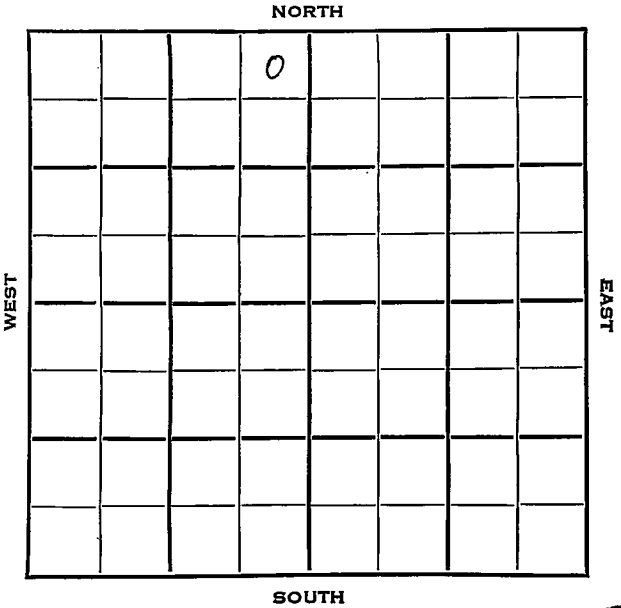

3


SEC.	TWP.	R.
7	8	28 W ✓

WELL NO. # 1 James FARM

COMPANY Cities Service

CONTRACTOR

Wildcat  
 330 Ft. from N. Line  
 Ft. from S. Line  
 330 Ft. from E. Line  
 Ft. from W. Line

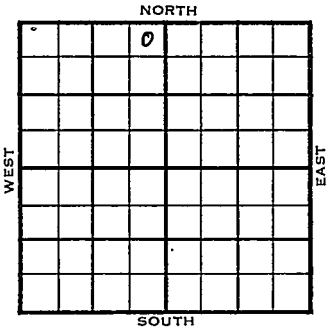

NE NE NW

	ELEVATION	REPORT
--	-----------	--------

1954

2775'

2/3 Location  
 2/10 "  
 2/17 8" @ 280 w/215 Ft. Hays 885  
 Green Horn 1195 Dakota 1323  
 Morrison 1865 Anhy 2471  
 Drlg. 3670  
 2/24 Top 3680 Heeb 3898 Dodge 3919  
 DST 3920-33, 1 hr, 5' M 1120#  
 Lans. 3937  
 DST 4113-45, 1 hr, 12' M 960#  
 B KC 4177 Marm 4209 Cong 4472  
 Miss 4486  
 Drlg. 4509'  
 3/3 Spud 2-8-54  
 D&A  
 TD 4688'  
 8" @ 280'  
 Ft. Hays 885', Greenhorn 1195',  
 Dakota 1323', Morrison 1865', Anhy  
 2471', Top 3680', Heeb 3898', Dodge  
 3919'  
 DST 3920-33', opn 1 hr., rec. 5' mud,  
 1120#  
 Lans 3937'

(Information Brought Forward)

1954  
3/3

DST 4113-45', opn 1 hr., rec. 12' mud,  
960#

B KC 4177', Marm. 4209', Cong.  
4472', Miss 4486', Viola 4624', Simp  
4670', Arb. 4673'

TD 4688'

D&A

**ABANDONED**



