

Section 8 Township 8 Range 17WWell No. #1 Turner "B"Company Murfin Drlg.

NORTH

	0						
	.						

SOUTH

WEST

EAST

Rooks

KANSAS

SEC.	TWP.	R.
8	8	17 W ✓
WELL NO.		
# 1 Turner "B"		FARM
COMPANY		
Murfin Drlg.		
CONTRACTOR		


330 Ft. from N. Line

Ft. from S. Line

Ft. from E. Line

990 Ft. from W. Line

NE NW NW

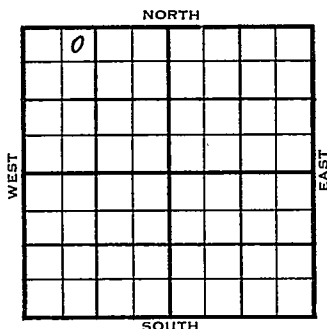

	ELEVATION	REPORT
1954	1883'	
2/10		Drlg. 1350'
2/17		8" @ 159 w/125 Anhy 1240 Top 2797 Heeb 3007' Tor 3032 Lans. 3052 DST 3139-56 1 hr, 117' SW 1100# BKC 3267 Arb. 3340 RTD 3348 5" @ ?
2/24		5" @ 3342
3/3		"
3/10		NR
3/17		Spud 2-7-54 D&A TD 3348' 8" @ 159' Anhy 1240', Top 2797', Heeb 3007', Tor 3032', Lans 3052' DST 3139-56', opn 1 hr., rec. 117' SW 1100# B KC 3267', Arb. 3340' TD 3348' 5" @ 3342' DD 3350', 1000A S/dry D&A

ABANDONED

County Rooks State Kansas
 Sec. 8 (Blk.) 8 (Sur.) 17W Map No.
 Operator Murfin Drlg.
 Well No. 1 Farm Turner "B"
 Elev. Location NE NW NW

0							

330 Ft. From N Line NW
990 Ft. From W Line Quarter
 1st. Report FEB 10 1954

Completion

Remarks

Spudding Date

Drlg. Data

drlg. 1350

J. G. McGEHEE

J. G. McGEHEE