Rooks KANSAS

8 8 17W

SECTION TOWNSHIP RANGE


#2 Turner "B"

WELL NO.

Murfin Drlg.

COMPANY

NORTH SW NW NW

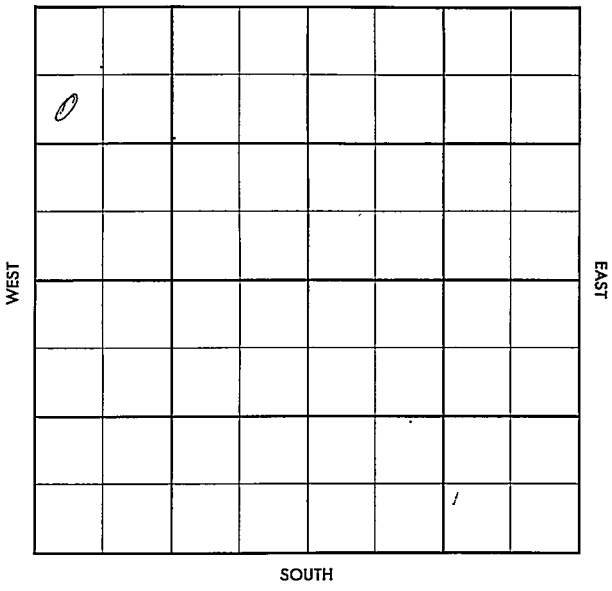

FORM 504-3 SUNRAY

FORM 513 SUNRAY

County Rooks Elev.

Sec. 8 Twp. 8 Rge. 17W

Company Murfin Drlg.

Farm Name Turner "B" No. 2

TOPS	DEPTH	LOG	DATUM
Anh.			
Tp.			
H.			
Tr.			
Dg.			
Bl.			
L.			
K.C.			
B.K.C.			
Ce.			
C.			
M.			
M.			
K.			
Mz.			
Mo.			
V.			
S.			
S.			
A			
R.			
P€.			
G.			
T.D.			

Loc. in Sec. SW NW NW

Geol.

Contr. Co. tools

Pool Lone Star

0

FIRST REPORT

FEB 27 57

Date Comm. 2-25-57

8" @ 162

No.

Sec.

T.

R.

FORM 513 SUNRAY

County Rooks Elev. 1926 KB

Sec. 8 Twp. 8 Rge. 17W

Company Murfin Drlg.

FarmName Turner "B" No. 2

TOPS	DEPTH	LOG	DATUM
Anh.			
T.P.	2841		
H.	3051		
Tr.	3075		
Dg.			
Bl.			
L.	3094		
K.C.			
B.K.C.			
Ce.			
C.			
M.			
M.			
K.			
Mz.			
Mo.			
V.			
S.			
S.			
A	3367		
R.			
P€.			
G.			
T.D.	3374		

Loc. in Sec. SW NW NW

Geol.

Contr. Co. tools

Pool Lone Star

c

APR 10 '57

COMPLETE

Date Comm. 2-25-57

8" @ 162 MAR 6 '57 4½ 3300 MAR 13 '57

RTD 3374 5½ 3369 175

MICT MAR 20 '57 CO 3374 ~~TD~~ TD

FO 325 oil 8 hrs & 16 Gaph

no lw 1½ & 5 Bopb 4 hrs

~~MAR 24 '57~~ MAR 27 '57 APR 3 '57 ✓ APR 10 '57

P. rate 25 Bopd no lwtr

Co. Lse. No. Sec. T. R.