


ROOKS

KANSAS

SECTION 8 TOWNSHIP 8S RANGE 17W

WELL NO. #1 Shindler "A"

COMPANY R. P. Nixon

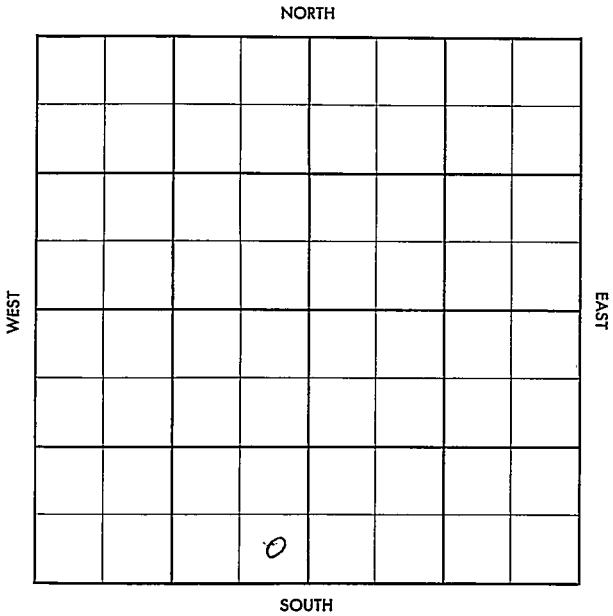

SEC. 8 TWP. 8S R. 17W

WELL NO. #1 Shindler "A" FARM

COMPANY R.P. Nixon


CONTRACTOR

FT. FROM N. LINE

FT. FROM S. LINE

FT. FROM E. LINE

FT. FROM W. LINE

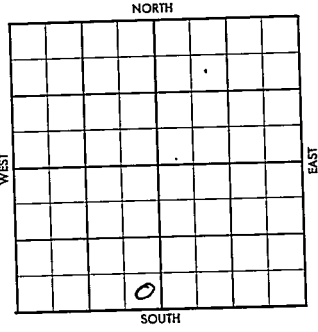

SE SE SW

1956 ELEVATION 1863 RB REPORT

6-13 Comm.
6-20 6-6-56
Comm. 6-8-56
8 5/8" @200 w/150
DST 3115-26', op 15 min, rec. 8' mud
BHP 610/ 20"
DST 3302-06, op 15 min, rec. 2' mud
BHP 40/ 20"
DST 3306-16, op 15 min, rec. 3' mud
BHP 300/ 20"
DST 3316-26, op 15 min, rec. 6' mud
BHP 150/ 20"
DST 3326-35, op 15 min, rec. 6' mud
BHP 170/ 20"
D & A
Tp. 2782', H. 2980', Tr. 3003',
L. 3022', A. 3300',
TD 3335'

ABANDONED

County Rooks Elev. _____
 Sec. 8 Twp. 8S Rgs. 17W
 Company _____
 Farm Name R. P. Nixon
Shindler "A" No. 1

TOPS	DEPTH	LOG	DATUM	Loc. in Sec.						
Anb.				SE SE SW						
Tp.										
H.				Geol. _____						
Tr.										
Dg.				Contr. _____						
Bl.										
L.				Pool _____						
K.C.										
B.K.C.				<table border="1"> <tr> <td colspan="2">FIRST REPORT</td> </tr> <tr> <td colspan="2">JUN 13 1956</td> </tr> <tr> <td> </td> <td> </td> </tr> </table>	FIRST REPORT		JUN 13 1956			
FIRST REPORT										
JUN 13 1956										
Ce.										
C.										
M.										
M.										
K.										
Mz.										
Ma.										
V.										
S.										
S.										
A.										
R.										
PE.										
G.										
T.D.										

Date Comm. to go 6/6/56

W. R. HULL

6.5

Co.

Lsec.

No.

Sec.

T.

R.

County Rooks Elev. 1863 RB
 Sec. 8 Twp. 8S Rge. 17W
 Company R. P. Nixon
 Farm Name Shindler "A" No. 1

TOPS	DEPTH	LOG	DATUM	Loc. in Sec.
Anh.				SE SE SW
Ip.	2782			
H.	2980			
Tr.	3003			
Dg.				
Bl.				
L.	3022			Geol.
K.C.				Contr.
B.K.C.				
Ce.				
C.				
M.				
M.				Pool
K.				
Mz.				
Mo.				
V.				
S.				
S.				
A.	3300			
R.				
PE.				
G.				
TD.	3335			

JUN 20 1956
 ABANDONED

Date Comm. to go 6/6/56 JUN 20 '56 6-8-56
 8 7/8 200/150 DST 3115-26 15" rec 8' Md BHP 610/20"
 DST 3302-06 15" rec 2' Md 40/20" DST 3306-16 15" rec 3' Md BHP 300/20" DST 3316-26 15" rec 6' Md BHP 150/20" DST 3326-36 15" rec 6' Md 170/20"

D & A