
FORM 51 IOM 12-46 PETROL KANSAS

Cloud

Section 8 Township 8 Range 4-W

Well No. #1 C. E. Blake

Company Cities Service

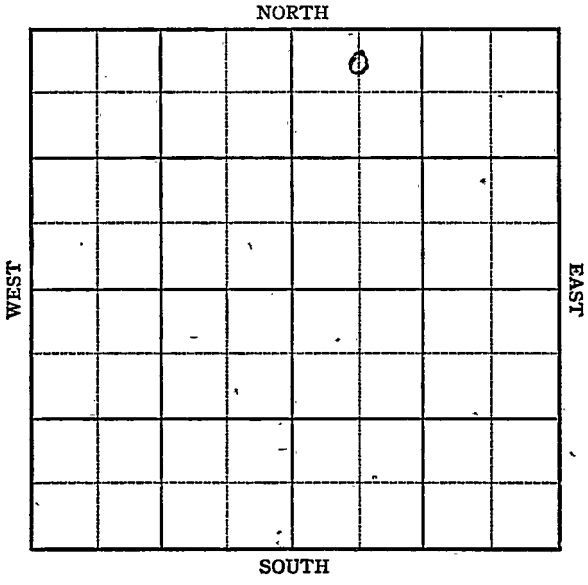

FORM 252-A
5M 12-46 PETROL

KANSAS

Cloud

Sec. 8 Twp. 8 R. 4-W

Well No. #1, C.E. Blake (Strat) Farm

Cities Service Oil Company Company


Wildcat

330' Ft. from N. Line

Ft. from S. Line

Ft. from E. Line

660' Ft. from W. Line

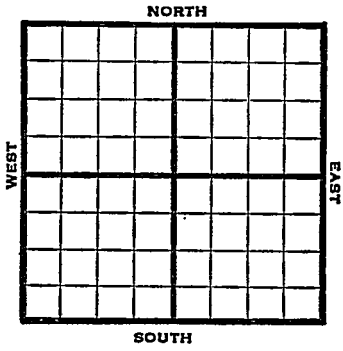

1947 Elv. 1428' REPORT

1/15

T.D. 3611'
8" @ 196'
Topeka 1835'
Lans. 2235'
Miss. 2823'
Hunton 3117'
Viola 3317'
Simp 3317'
Arbuckle 3598'

FIRST REPORT

ABANDONED

Form 26 200 Bks. 10-46 Petrol

Wildcat

KANSAS

Kansas

Map No. 39 Sec. 8 Twp. 8 R. 4W

Well No. 1 C. E. Blake (Strat)

Cities Service Company

FIRST REPORT

ABANDONED

Contractor

E 1,1428.

C N L NW NE


330 Ft. from N. Line

Ft. from S. Line

Ft. from E. Line

660 Ft. from W. Line

SECTION PLAT

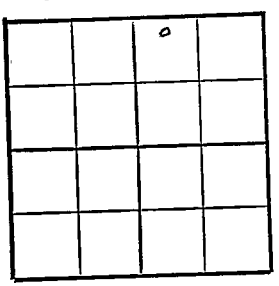

Cloud County

Location

Rig up

Drilling and Remarks:

8"@196

Top. 1595

Lans 2285

Miss 2823

Hunton 3117

Viola 3317

RECORD

Cased in., ft.

Sand

Gas

Oil

Total Depth 3321

PRODUCTION

1st 24 hrs. Nat.

1st 24 hrs. after shot

Gas Cu. Ft.

Dry Hole

Abandoned

Date

JAN 15 1947 19

S. LEWIS Scout