

Section 8 Township 8 Range 18W

Well No. 1 Ververka

Company Hinkle Oil et al

Wildcat

NORTH

WEST

EAST

0							

SOUTH

KANSAS

Rooks

Sec. 8 Twp. 8 R. 18W ✓

Well No. #1 Ververka Farm

Hinkle Oil et al Company


Wildcat

330' Ft. from N. Line

_____ Ft. from S. Line

_____ Ft. from E. Line

330' Ft. from W. Line

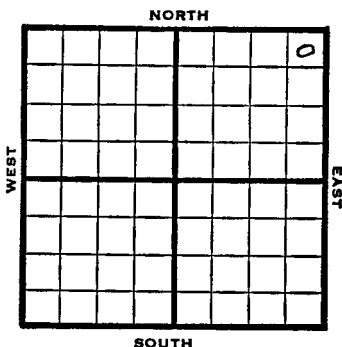

NW/C

1949	Elev 1943' REPORT
4/20	8" @ 95'
4/27	Lansing 3136'
	Drlg 3190'
5/4	TD 3443'
	Arb. 3411'
	Aband.
	ABANDONED

Kansas

Map No. _____ Sec. 8 Twp. 8 R. 18W

Well No. 1 Ververka

Hinkle Oil etal.

Company

FIRST REPORT

Contractor

NW/C


SECTION PLAT

330 Ft. from N. Line

Ft. from S. Line

Ft. from E. Line

330 Ft. from W. Line

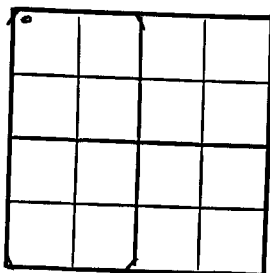

Rooks County

Location _____

Rig up _____

Drilling and Remarks:

8" @ 95

RECORD

Cased _____ in., _____ ft.

Sand _____

Gas _____

Oil _____

Total Depth _____

PRODUCTION

1st 24 hrs. Nat. _____

1st 24 hrs. after shot _____

Gas _____ Cu. Ft.

Dry Hole _____

Abandoned _____

Date

APR 20 1949

19

S. J. LEWIS

Scout

Map No. K-64 Sec. 8 Twp. 8 R. 18W

Well No. 1 Ververka

Hinkle Oil etal. Company

ABANDONED

Contractor

NW/C


E. 1943
SECTION PLAT

330 Ft. from N. Line

_____ Ft. from S. Line

_____ Ft. from E. Line

330 Ft. from W. Line

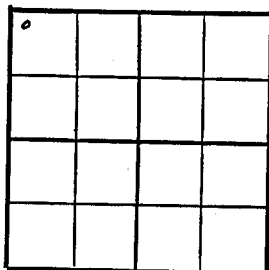

Rooks County

RECORD

Location _____

Rig up _____

Drilling and Remarks:

Per 8411

Cased _____ in., _____ ft.

Sand _____

Gas _____

Oil _____

Total Depth 3443

PRODUCTION

1st 24 hrs. Nat. _____

1st 24 hrs. after shot _____

Gas _____ Cu. Ft.

Dry Hole _____

Abandoned _____

Date

MAY 4 1949 19

S. J. LEWIS Scout