


Section 8 Township 8 Range 25 W

Well No. # 1 H. Madden

Company Empire Drlg.

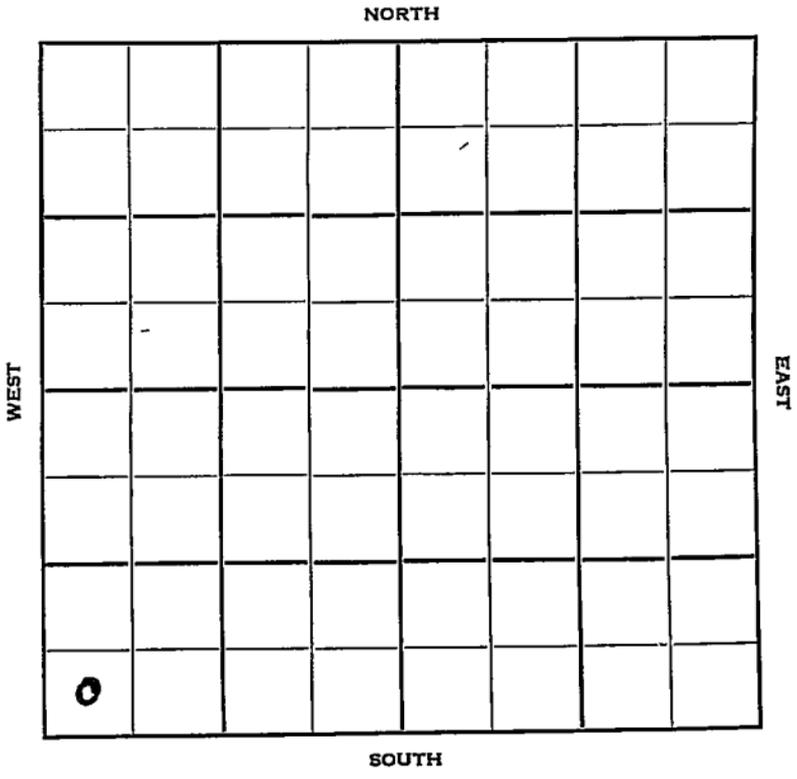

13

Sec. 8 Twp. 8 R. 25 W

Well No. # 1 H. Madden Farm

Empire Drlg. Company

Empire Drlg. Contractor


Wildcat

Ft. from N. Line

330 Ft. from S. Line

Ft. from E. Line

330 Ft. from W. Line

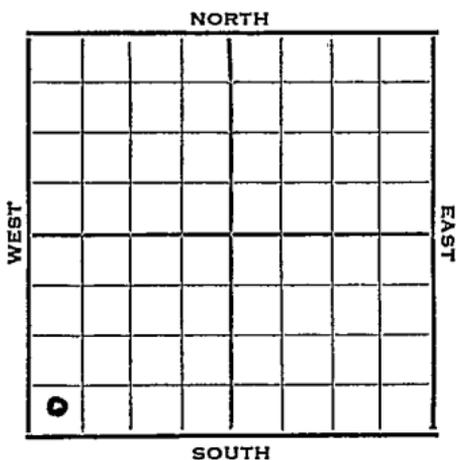

SW SW SW  
Texas DHM \$3500

1952 Elev. 2431' REPORT

9/10 Location  
9/17 8" @ 193  
Drlg. 2295'

9/24 Anhy 2130' Topeka 3504' Lans. 3749'  
DST 3872-80, 1 hr, 90' M, 1300#  
DST 3880-3927', 1/2 hr, 10' SOCM  
35#  
Drlg. 4005'

10/1 Spud 9-13-52  
D & A TD 4480' 8" @ 193  
Anhy 2130' Top 3504' Lans. 3749'  
DST 3872-80 open 1 hr. rec 90' mud  
1300#  
DST 3880-3927 open 1/2 hr, rec 10' SOCM  
35# Arb. 4429' TD 4480'  
D & A

**ABANDONED.**



