

Graham KANSAS


DX 78-1

Section 8 Township 8 Range 25W

Well No. 3 Madden-Davis "C"

Company Harry Gore

NORTH

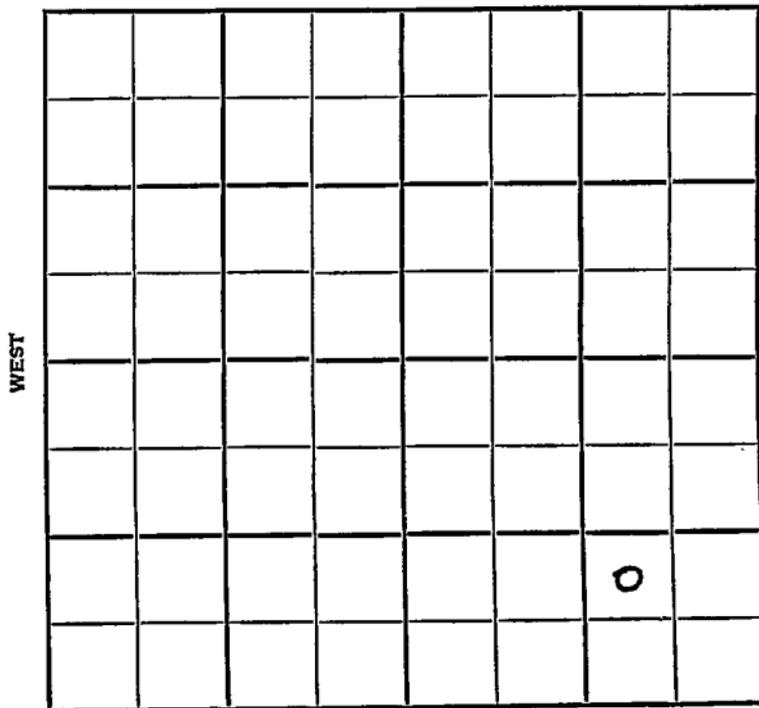

SOUTH

18

Graham KANSAS


SEC.	TWP.	R.
8	8	25W

WELL NO. 3 Madden-Davis "C" FARM

COMPANY Harry Gore

CONTRACTOR Empire Drlg.  
Schmied Pool

\_\_\_\_\_ Ft. from N. Line  
990 \_\_\_\_\_ Ft. from S. Line  
990 \_\_\_\_\_ Ft. from E. Line  
\_\_\_\_\_ Ft. from W. Line

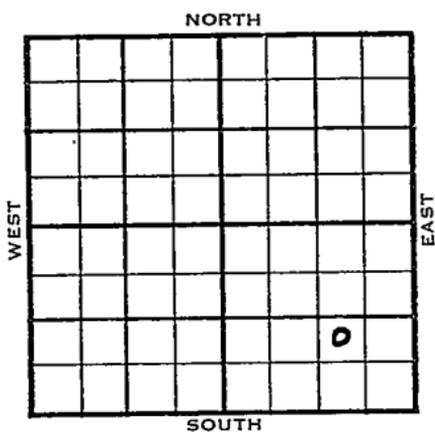

NW SE SE

	ELEVATION	REPORT
1954	2433'	
7/28	M I R	
8/25	Spud 7-26-54 D&A TD 3890' 8" @ 161' Heeb 3680', Tor 3701', Lans 3716' TD 3890' 5" @ 3883' CO to 3890', 3000A S/5 bwph 15% oil SP 3870' 24/3850-56, FU 200' wtr. SP 3810', 24/3795-3801' FU 100' SW, 2 1/2 BWP SP 3766 24/3750-56 FU Wtr. D&A	
		<b>ABANDONED</b>



