

Graham

Kansas


DX 78-1

Section 8 Township 8 Range 25W

Well No. #1 Madden-Davis "C"

Company Empire Drilg. Harry Gore

NORTH

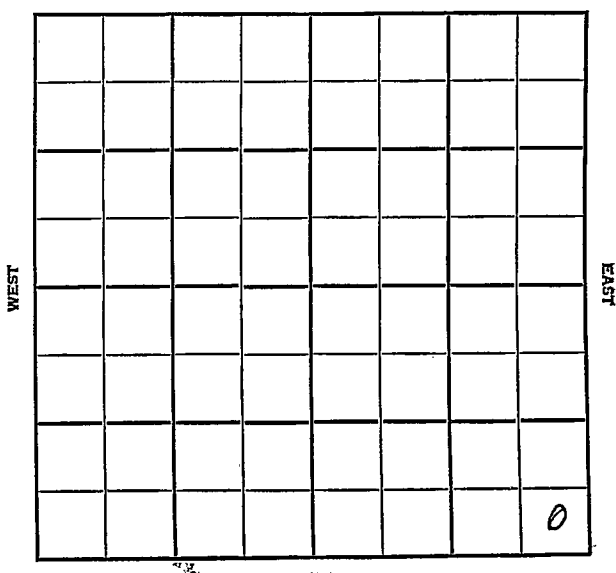

SOUTH

16

KANSAS

TWP

R.

8

8

25 W

WELL NO.

1 Madden-Davis "C"

COMPANY

FARM

~~Harry Gore~~
~~Empire Drlg.~~

CONTRACTOR

Empire

Schmeid Pool

Ft. from N. Line

330

Ft. from S. Line


330

Ft. from E. Line

Ft. from W. Line

SE SE SE

NORTH

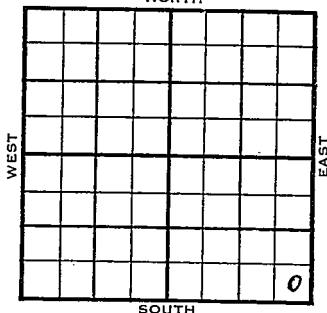

1954

ELEVATION

2442

REPORT

5/19

Location

~~6/2XXXXXRTDX8899~~

5/26

8" @ 176 w/110

Drlg. 2400

6/2

RTD 3899 5" @ 3892

6/9

Heeb 3694' Tor. 3714' Lans 3726'

6/30

Spudding 5-20-54

Oil well

LD 3899

8" @ 176

Heeb 369⁴ Tor. 371⁴ Lans. 372⁶

TD 3899

5" @ 3892

CO to 3899 3000 A S/20 boph 8 hr.

Comp. 314 bopd 3% wtr.

COMPLETED

J. G. McGEHEE

Kansas.

Map No. _____ Sec. 8 Twp. 8 R. 25WWell No. 1 Madden-Davis "C"Harry Gore

Company

CORRECTION

Contractor

SE SE SE

SECTION PLAT

			o

_____ Ft. from N. Line

330 _____ Ft. from S. Line330 _____ Ft. from E. Line

_____ Ft. from W. Line

Graham County

Location _____

Rig up _____

Drilling and Remarks:

Reported

Empire Drlg.

RECORD

Cased _____ in., _____ ft.

Sand _____

Gas _____

Oil _____

Total Depth _____

PRODUCTION

1st 24 hrs. Nat. _____

1st 24 hrs. after shot _____

Gas _____ Cu. Ft.

Dry Hole _____

Abandoned _____

Date


JUN • 3 • 1954

J. G. McGEHEE

19

Scout

County Graham State Kansas
 Sec. 8 (Blk.) 8 (Sur.) 25W Map No.
 Operator Harry Gore
 Well No. 1 Farm Madden-Davis "C"
 Elev. 2442 Location SE SE SE

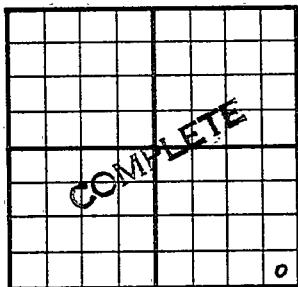

330 Ft. From S Line SE
330 Ft. From E Line Quarter

1st. Report

Completion JUN 30 1954

Remarks Schmeid Pool

Empire - Contr.

Spudding Date 5-20-54

Drilg. Data Oil well TD 3899

8" @ 176 Heeb. 3694 Tor. 3714

Lans. 3726 TD 3899 5" @ 3892

CO to 3899 3000 A S/ 20 boph 8 hr.

Comp. 314 bopd 3% wtr.

J. G. McGEHEE