


Graham **KANSAS**

SECTION 8 TOWNSHIP 8 S RANGE 23 W

WELL NO. #2
#1 Montgomery

COMPANY J. O. Farmer

NORTH S/2 S/2 NE

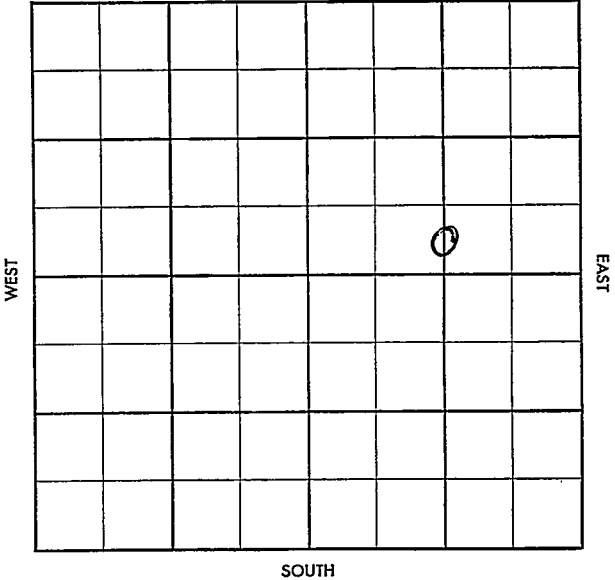

8

~~Topographic Map~~
~~County~~ ~~East~~
~~West~~

S-513-B

County Graham Elev. _____
 Sec. 8 Twp. 8 Rge. 23W
 Company J. O. Farmer
 Farm Name Montgomery No. 1

TOPS	DEPTH	LOG	DATUM
Anh.			
Tp.			
H.			
Tr.			
Dg.			
B.L.			
L.			
K.C.			
B.K.C.			
Ce.			
C.			
M.			
M.			
K.			
Mz.			
Mq.			
V.			
S.			
S.			
A.			
R.			
Pf.			
G.			
T.D.			

Loc. in Sec. S/2 S/2 NE

Geol. _____
 Contr. _____
 Co. Tools # 1

Pool Montgomery

ML 23-58
FIRST REPORT

Date Comm. 7-19-58
8" @ 165 w/150, Drlg. 2560

Co.
 Use
 No.
 Sec.
 T.
 R.

Twp. 17C Pool 17C
 Co. 130 Facet 130


CORRECTION

5-513-B

County Graham Elev. 2249 RB224700
 Sec. E Twp. 8 Rge. 23E
 Company J. C. Farmer
 Farm Name Montgomery No. 42

TOPS	DEPTH	LOG	DATUM
Anh.			
Tp.			
H.	<u>3469</u>		
Tr.	<u>3495</u>		
Dg.			
B.L.			
L.	<u>3510</u>		
K.C.			
B.K.C.	<u>3720</u>		
Ce.			
C.			
M.			
M.			
K.			
Mz.			
Mq.			
V.			
S.			
S.			
A.			
R.			
PF.			
G.			
T.D.	<u>3740</u>		

Loc. in Sec. S/2 S/2 NE
 Geol. _____
 Contr. _____
 Co. Tools 77A
 Pool Montgomery

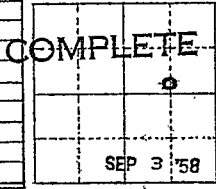

Date Comm. 7-15-58

6" @ 165 w/150, Drlg. 2560 JUL 30 '58 DST
3530-45 1hr 70' H08 gem
205' gray oil 170' W 13HP
1260/20" DST 3550-65 1hr
540 gip 1380' oil FP520
BHP 1020/20 DST 3573-90
1hr 80' oil 80' H08 gem 40' MW
FP160 BHP 1200/20" DST
3640-82 30" 10' M BHP 160/20

5 1/2 3739 AUG 6 '58 AUG 13 '58

12/3572-75 1/2 \$1080ph + 2626

W NT PB 3562 16/ 3548 - 52

1/2 \$ 2380ph + 190 W 150008

NT POP AUG 20 '58 AUG 27 '58 SEP 3 '58

Phy P193 BO NW

¢

✓
EI 2249

TD 1491

PB 1313

5½ 1490

Pf. 1298-1303