
Graham KANSAS

SECTION 8 TOWNSHIP 8S RANGE 23W

WELL NO. #1 Ellsworth "B"

COMPANY J.O. Farmer, Inc.

NORTH NW NW SE

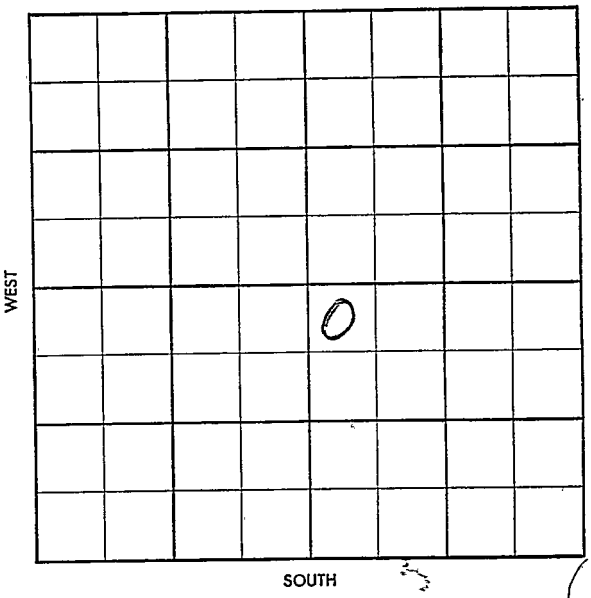

9

OK

FORM 504-S SUNRAY

S-513-B

County Graham Elev.

Sec. 8 Twp. 8 Rge. 23W

Company J. O. Farmer, Inc.

Farm Name Ellsworth "B" No. 1


TOPS	DEPTH	LOG	DATUM
Anh.	1848		
Tp.			
H.			
Tr.			
Dg.			
B.L.			
L.			
K.C.			
B.K.C.			
Ce.			
C.			
M.			
M.			
K.			
Mz.			
Mq.			
V.			
S.			
S.			
A.			
R.			
Pf.			
G.			
T.D.			

Loc. in Sec. NW NW SE

Geol. Farmer

Contr. Co. Tools #1

Pool

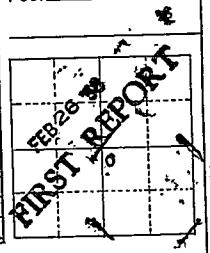

Date Comm. 2/22/58

8" @ 167 w/125, Drlg. 2325

Co. Lse. No. Sec. T. R.

Twp. X Pool X

Co. X Facet X

B-513-B

County Graham Elev 2230 DF 2235 KB

Sec. 8 Twp. 8S Rge. 23W

Company J. O. Farmer, Inc.

Farm Name Ellsworth "B" No. 1


TOPS	DEPTH	LOG	DATUM
Anh.	1848		
Tp.			
H.		3428	
Tr.		3450	
Dg.			
B.L.			
L.		3466	
K.C.			
B.K.C.		3678	
Ce.			
C.			
M.			
M.			
K.			
Mz.			
Mq.			
V.			
Sr.			
S.			
A.			
R.			
Pf.			
G.			
T.D.	3700		

Loc. in Sec. NW NW SE

Geol. Farmer

Contr. Co. Tools #1

Pool Higer NE

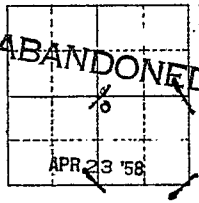

Date Comm. 2/22/58

8" @ 167 w/125, Drlg. 2325 MAR 5 '58 Ø3050

MAR 12 '58 DST 3486-3511 60" 50'H DCM 180' OCM 60' SW BHP 1200 DST 3518-45 60" 270' HOCM 140' free oil 10' W BHP 1180 DST 3603-25 30" 1'M BHPO DST 3621-60" 30" 3'M BHP 1080 DST 3660-80 30" 3'M BHPO 5½ 3600/125 MAR 19 '58

MAR 26 '58 APR 2 '58 APR 9 '58 APR 16 '58 ⊙ 20/3530-35 $2.34 BFPH 80% w 6hrs SI WOO

FORM 513-1 SUNRAY

APR 23 '58 CO Leaked 12/3531-34 (½)
$Ld-6 5½ BFph 90% w PB
3520 12/3508-11 $ ½ g o 3½gw
3 hrs (½) $ 4.38 BFph 75% w
PB 3502 ₱ dry 2₱/3294-3500
₱: 12gw ph + oil 5 hrs

D&A

8-9-23W NW NW SE