

Rooks

DX 78-1

KANSAS
17W

Section 9 Township 8 Range

Well No. #3 Arndts

Company V.D. Sidey

NORTH

7

0							

WEST

EAST

SOUTH

Rooks KANSAS


SEC.	TWP.	R.
9	8	17 W

WELL NO. # 3 Arndts FARM

COMPANY V. D. Sidey

CONTRACTOR Sidey Lone Star Pool

330 Ft. from N. Line
 Ft. from S. Line
 Ft. from E. Line
 330 Ft. from W. Line

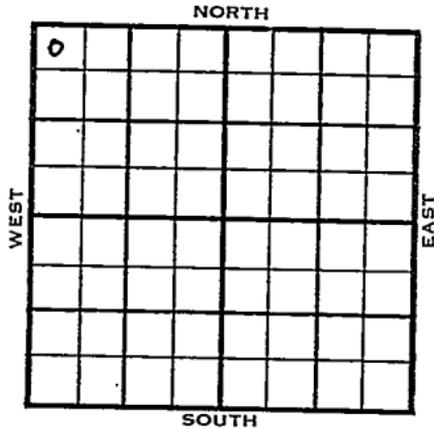

NW NW NW

1954	ELEVATION	REPORT
	1952'	

9/8 Spud 8-3-54
 10/6 Spud 8-3-54 - Oil Well
 TD 3398'
 Heeb 3063', L ans 3106', Arb. 3389'
 TD 3398'
 5" @ 3390' 1000A
 CO to TD
 Comp. 115 BOPD 45% wtr.

COMPLETED

County Rooks State Kansas

Sec. 9 (Blk. Twp.) 8 (Sur. Rge.) 17W Map No.

Operator V. D. Sidey

Well No. 3 Farm Arndts

Elev. Location NW NW NW

0					

330 Ft. From N Line NW r

330 Ft. From W Line Quarter

1st. Report SEP 8 1954

Completion

Remarks

Sidey - Contr.

Spudding Date 8-3-54

Drig. Data Lone Star Pool

County _____ Rocks _____ State **Kansas**

Sec. **9** (Blk.) **8** (Sur.) **17W** Map No. _____
 (Twp.) _____ (Rge.) _____

Operator **V. D. Sidey**

Well No. **3** Farm **Arndts**

Elev. **1952** Location **NW NW NW**

0					
COMPLETE					

330 Ft. From **N** Line **NW**

330 Ft. From **W** Line **Quarter**

1st. Report _____

Completion **OCT 6 1954**

Remarks **Lone Star Pool**

Sidey - Contr.

Spudding Date **8-3-54**

Drlg. Data **Oil well** TD **3398**

Heeb. **3063** Lans. **3106** Arb. **3389**

TD **3398** 5" @ **3390** 1000 A **DO to TD**

Comp. **115 bopd** 45% wtr.

FABEN GILSTRAP