


Section 9 Township 8 Range 25W

Well No. 2 Bell Paxton

Company Empire Drlg.

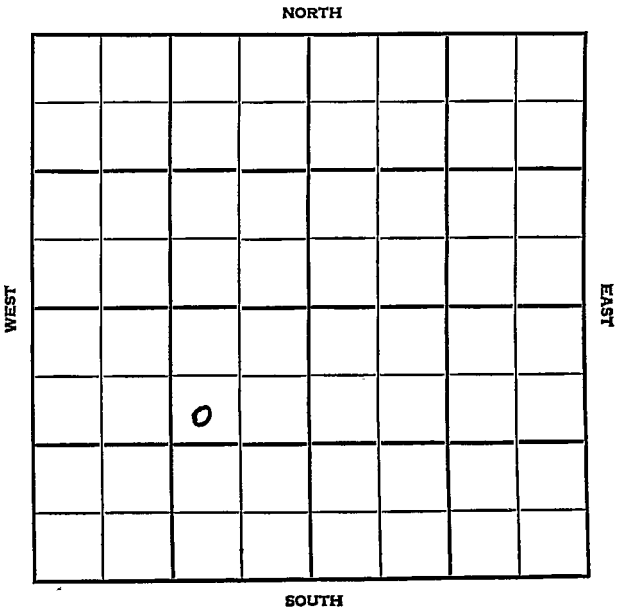

Graham

9 5AS

SEC.	TWP.	R.
9	8	25 W

WELL NO.

2 Bell Paxton

COMPANY

FARM

Empire Drlg.

CONTRACTOR

Co. tools

Schmeid Pool


990 Ft. from N. Line

Ft. from S. Line

990 Ft. from E. Line

Ft. from W. Line

SW NE SW

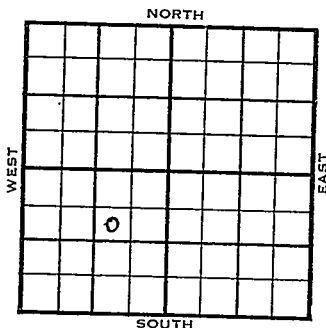

	ELEVATION	REPORT
1954	2437'	

10/13 Spud 10-11-54
8" @ 173 WOC

10/27 Spud 10-11-54 - D&A
TD 3910'
8" @ 173'
Anhy 2141', Heeb 3709', Tor 3729',
Lans 3742'
DST 3863-80', opn $\frac{1}{2}$ hrs., rec. 10'
mud, 110#
TD 3910'
D&A

ABANDONED

County Graham State Kansas

Sec. 9 (Blk. 8 (Sur. 25 Map No.

Operator **Empire Drlg.**

Well No. **2** Farm **Bell Paxton**

Elev. _____ Location: **SW NE SW**

FIRST REPORT			
0			

990 Ft. From N Line SE

990 Ft. From E Line . Quarter

1st. Report OCT 13 1954

Completion

Remarks

Co. tools


Spudding Date **10-11-54**

Dr. Data Schmeid Pool

8th @ 173 WOC

FABEN GILSTRAP

County Graham State Kansas
 Sec. 9 (Blk.) 8 (Sur.) 25W Map No.
 Operator Empire Drlg.
 Well No. 2 Farm Bell Paxton
 Elev. 2437 Location SW NE SW

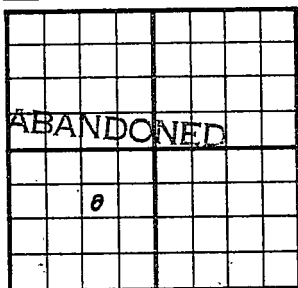

990 Ft. From N Line SW
990 Ft. From E Line Quarter
 Ist. Report
 Completion OCT 27 1954
 Remarks Schmeid Pool
Co. tools
 Spudding Date 10-11-54

Drlg. Data D & A TD 3910
8" @ 173 Anhy 2141 Heeb. 3709
Tor. 3729 Lans. 3742 DST 3863-80
open $\frac{1}{2}$ hr. Rec. 10' mud 110# TD 3910
D & A

FABEN GILSTRAP