


Section 9 Township 8 Range 20W

Well No. #1 Braun

Company B & R Drlg.

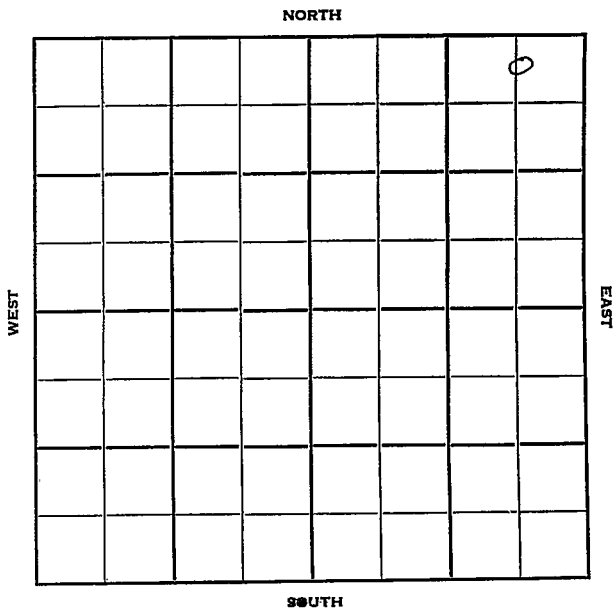

Rooks

KANSAS

Sec. 9 Twp. 8 R. 20 W

Well No. # 1 Braun Farm

B & R Drilling Company


Wildcat Contractor

330 Ft. from N. Line

_____ Ft. from S. Line

660 Ft. from E. Line

_____ Ft. from W. Line

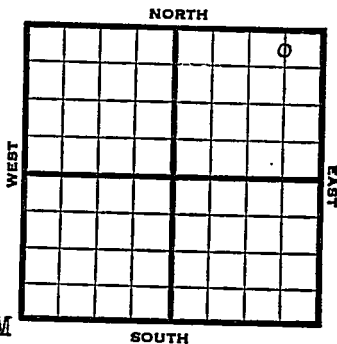

C N/2 NE NE

Sinclair & Magnolia DHM

1951

Elev. 1925' REPORT

6/13

Cellar & Pits

7/11

D&A TD 3460

Anhy 1480 Heeb. 3117 Lans. 3157

BKC 3375 Arb. 3425

DST 3425-28 opn 1 hr Rec. 2' mud

TD 3460 D&A

ABANDONED

County Rooks State Kansas

Sec. 9 (Blk. Twp.) 8 (Sur. Rge.) 20W Map No.

Operator R & R Drilling

Well No. 7 Farm Bram

Elev. Location 1/2 NE NE

FIRST REPORT

330 Ft. From N Line 100

660 Ft. From E Line 100 Quarter

Ist. Report JUN 13 1944

Completion

Remarks

Sinclare & Magnolia - DEM

Spudding Date

Drlg. Data

Cellar & Pits

Wildcat

