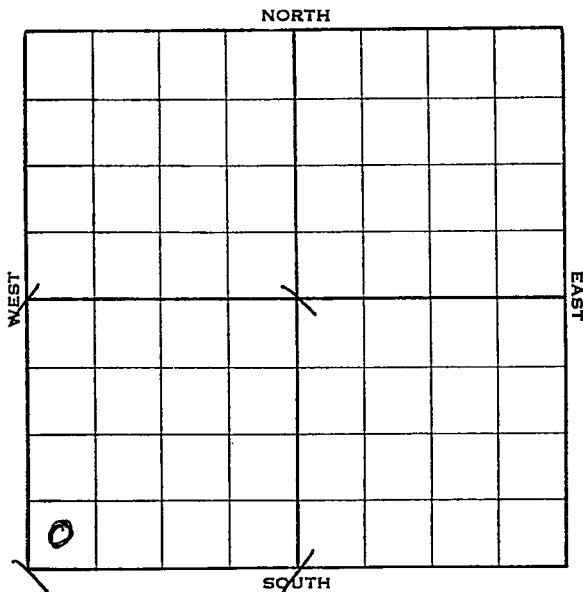


Rooks

KANSAS

Section 1 Township 9 Range 17-WWell No. 1 LarsonCompany Leavell et al

KANSAS

Rooks

Sec. 1 Twp. 9 R. 17-W

Well No. #1 Larson Farm
Leavell et al Company


_____Ft. from N. Line

330 Ft. from S. Line

Ft. from E. Line

330 Ft. from W. Line

Elev. 1996

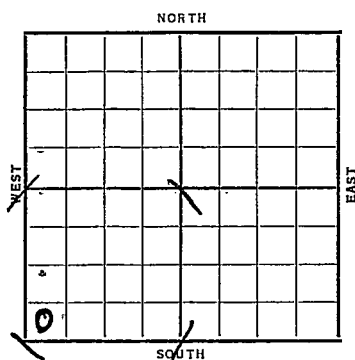

Date	REPORT
1938	
3/23	Cellar.
3/1	10" @ 85'.
	Drlg. 185'.
4/8	Anhy 1255'. Fort Riley 1990'.
	Drlg. 2020'.
4/15	Drlg. 2750'.
4/22	K.C. 3135'. Drlg. 3320'.
4/29	Arb. 3435-41' T.D. S.O.
	7" @ 3434'. RUST.
5/6	T.D. 3446'. Sm. show oil.
	Will P. B.
5/12	P.B. 3400'. Small S.O. & 3 BWPH
	500 acid.
	OVER

1938

5/18

7" @ 3434'.

Arb. 3435'.

T.D. 3449'.

P.B. 3400'.

1000 acid.

ABANDONED

Map No. 64 Sec. 1 Twp. 9 R. 17WWell No. 1 LarsonLeavell etal

Company


Contractor

FIRST REPORT.

SW/C

 Ft. from N. Line330 Ft. from S. Line Ft. from E. Line330 Ft. from W. Line

SECTION PLAT

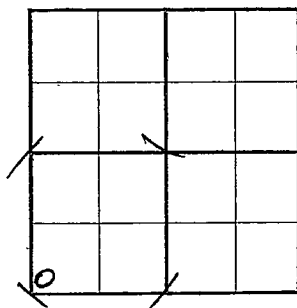Location Rig up

Drilling and Remarks:

Cellar

RECORD

Cased in., ft.Sand Gas Oil Total Depth

PRODUCTION

1st 24 hrs. Nat. 1st 24 hrs. after shot Gas Cu. Ft.Dry Hole Abandoned

Date

MAR 23 1938

19

H. D. Hatfield Scout

Rocks **KANSAS**Map No. 64 Sec. 1 Twp. 9 R. 17WWell No. 1 LarsonLeavell etal

Company

Contractor

ABANDONED**SW/C****SECTION PLAT**

_____ Ft. from N. Line

330 Ft. from S. Line

_____ Ft. from E. Line

330 Ft. from W. Line

Location _____

Rig up _____

Drilling and Remarks:

P.B. 3400
1000 acid

D & A

RECORDCased 7 in. 3434 ft.Sand Arb 3435

Gas _____

Oil _____

Total Depth 3449**PRODUCTION**

1st 24 hrs. Nat. _____

1st 24 hrs. after shot _____

Gas _____ Cu. Ft.

Dry Hole _____

Abandoned _____

Date

MAY 18 1938 19H. D. Hatfield Scout