

KANSAS

FORM 51 5M 1-42 PETROL

Rooks

Section 1 Township 9 Range 19-W

Well No. #2 J. Jick

Company Continental

13

0									

NORTH

WEST

EAST

SOUTH

KANSAS

Rooks

Sec. 1 Twp. 9 R. 19-W

Well No. #2 J. Jick Farm


Continental Company

 Ft. from N. Line

330 Ft. from S. Line

 Ft. from E. Line

330 Ft. from W. Line

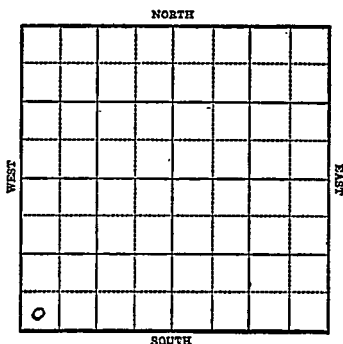

1943

Slev. 2032

R E P O R T

8/11	Derrick
8/18	10" @ 240' Drlg. 950'
8/25	Drlg. 3342'
9/1	Arb 3449-52 T.D. 6" D @ 3450 Rust
9/8	T.D. 3467 2800' oil swab 200 oil in 3 hrs
9/15	SD
9/22	"
9/29	"
10/6	"
10/9	"
10/20	Arb 3449 6" @ 3450 Echo Pot 3126 Max 3000 T.D. 3467 Gravity 27

COMPLETED

KANSAS

Map No. 65 Sec. 1 Twp. 9 R. 19WWell No. 2 J. JickContinental

Company

FIRST REPORT

Contractor

SW/C

SECTION PLAT

 Ft. from N. Line330 Ft. from S. Line Ft. from E. Line330 Ft. from W. Line

BARRY POOL

Location Rig up

Drilling and Remarks:

Derri ck

RECORD

Cased in., ft.Sand Gas Oil Total Depth

PRODUCTION

1st 24 hrs. Nat. 1st 24 hrs. after shot Gas Cu. Ft.Dry Hole Abandoned

Date


AUG 1 1 1943 19

S. J. LEWIS Scout

KANSASMap No. 835 Sec. 1 Twp. 9 R. 19WWell No. 2 J. JickContinental CompanyCOMPLETED Contractor

SW/C

SECTION PLAT

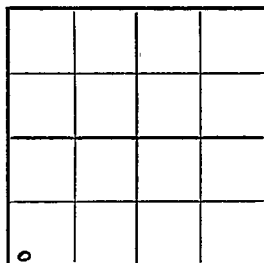 Ft. from N. Line330 Ft. from S. Line Ft. from E. Line330 Ft. from W. Line

Barry Pool

Location Rig up

Drilling and Remarks:

*CE 83445**6" @ 3450**Ecl 83126**Max 3000**27 1/2*

RECORD

Cased in., ft.Sand Gas Oil Total Depth 3467

PRODUCTION

1st 24 hrs. Nat. 1st 24 hrs. after shot Gas Cu. Ft.Dry Hole Abandoned

Date

OCT 20 1943

19

S. J. LEWIS

Scout