
DX 78-1

Rooks KANSAS

Section 1 Township 9 Range 19W

Well No. 1 Gick

Company Thunderbird Drlg.

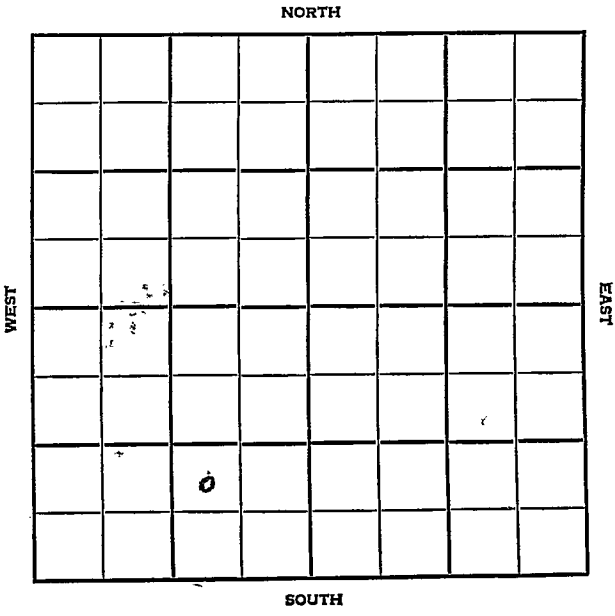

Rooks KANSAS

SEC.	TWP.	R.
1	9	19W

WELL NO.

1 Gick FARM

COMPANY

Thunderbird Drlg.

CONTRACTOR

Co. Tools

Barry Pool


_____ Ft. from N. Line

990 Ft. from S. Line

990 Ft. from E. Line

_____ Ft. from W. Line

NW SE SW

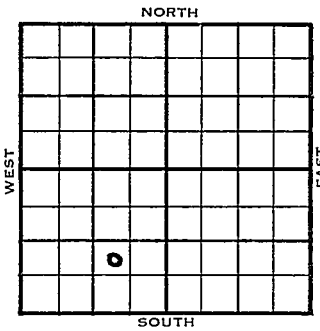

	ELEVATION	REPORT
1955	2049'	
1/12		Spud 1-7-55 8" @ 180' Anhy 1425' Drlg. 2320'
6/1		Comm 1-7-55 8" @ 180 Anhy 1425, H. 3197, L. 3237, A. 3482, TD 3485 DST 3214-47, open 1/2 hr. Rec 15' mud 875#, DST 3396-3428 open 1/2 hr. Rec 5' socm 130#, DST 3484-89 open 1 hr Rec 440' oil 100# TD 3485, 5" @ 3485 CO to 3489 500 A S/36 BO 100 Bw 12 hr P/320 bfpd 95% wtr (est 6½ bopd)
		COMPLETED

DX-78

FORM 275 FOR SALE BY KANSAS BLUE PRINT CO.

County Rooks State Kansas

Sec. 1 (Blk. Twp.) 9 (Sur. Rge.) 19W Map No.

Operator Thunderbird Drlg.

Well No. 1 Farm Gick

Elev. Location NW SE SW



990 Ft. From S Line SW

990 Ft. From E Line Quarter

1st. Report JAN 1 2 1955

Completion

Remarks

Co. tools

Spudding Date 1-7-55

Drlg. Data Barry Pool

8" @ 180 Anhy 1425 drlg. 2320

FABEN GILSTRAP

FORM 513 REV. SUNRAY

County Rooks Elev. 2049

Sec. 1 Twp. 9 Rge. 19W

Company Thunderbird Drlg.

Farm Name Gick No. 1

TOPS	DEPTH	LOG	DATUM
Anh.	1425		
T.P.			
H.	3197		1148
Tr.			
Dg.			
Bl.			
L.	3237		1188
K.C.			
B.K.C.			
Ce.			
C.			
M.			
M.			
K.			
Mz.			
Me.			
V.			
S.			
S.			
A	3482		1433
R.			
P€.			
G.			
T.D.	3485		

Loc. in Sec. NW SE SW

Geol.

Contr.

Pool Barry

COMPLETE

JUN 1 1955

Date Comm. 1-7-55

8" @ 180 DST 3214-47 open ½ hr.

Rec. 15' mud 875# DST 3396-3428

open ½ hr. Rec. 5' socm 130#

DST 3484-89 open 1 hr. Rec. 440' oil

100# TD 3485 5" @ 3485 CO to 3489

500 A S/36 bo 100 bw 12 hr.

P/ 320 bfpd 95% wtr. (est. 6½ bopd)

Co. Lse. No. Sec. T. R.