KANSAS

FORM 51 5M 10-41 PETROL


Rooks

Section 1 Township 9 Range 19-W

Well No. #1 Gick

Company Continental

13

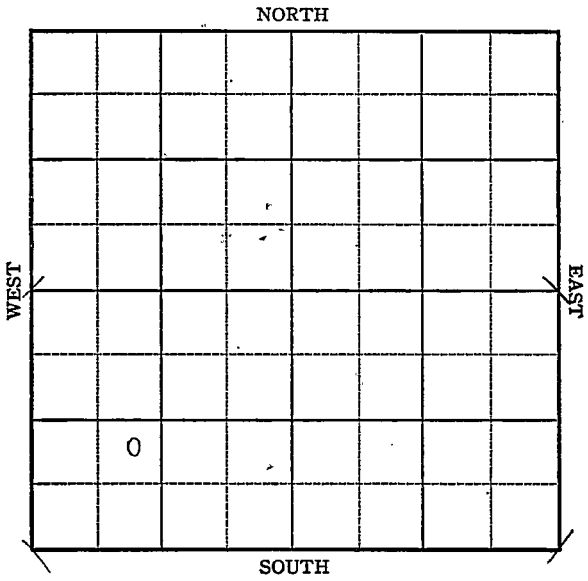

FORM 252-A
5M 9-42 GASS

KANSAS

Rooks

Sec. 1 Twp. 9 R. 19-W

Well No. #1 Gick Farm

Continental Company


Barry

_____ Ft. from N. Line

990 Ft. from S. Line

_____ Ft. from E. Line

990 Ft. from W. Line

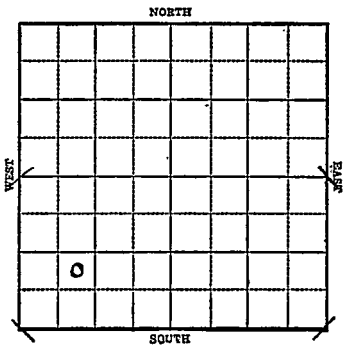

1943	REPORT
3/17	Location.
3/24	Rotary.
3/31	T.D. 250'
	ABANDONED

Form 26 200 Bks 5-42 Petrol

KANSAS

Rooks

Map No. 65 Sec. 1 Twp. 9 R. 19W


Well No. 1 Gick

Continental Company

FIRST REPORT Contractor

NE SW SW

SECTION PLAT

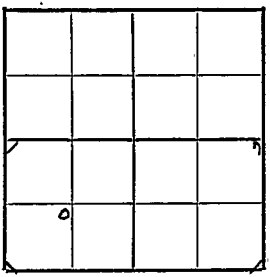

____ Ft. from N. Line

990 Ft. from S. Line

____ Ft. from E. Line

990 Ft. from W. Line

BARRY POOL

Location XXX

Rig up

Drilling and Remarks:

RECORD

Cased ____ in., ____ ft.

Sand

Gas

Oil

Total Depth

PRODUCTION

1st 24 hrs. Nat.

1st 24 hrs. after shot

Gas ____ Cu. Ft.

Dry Hole

Abandoned

Date

MAR 17 1943 19

S. J. LEWIS Scout

Form 26 200 Bks 5-42 Petrol

Rooks

Map No. 65T Sec. 1 Twp. 9 R. 19W

Well No. 1 Gick

Continental Company

ABANDONED Contractor

NE SW SW


Ft. from N. Line

990 Ft. from S. Line

Ft. from E. Line

990 Ft. from W. Line

SECTION PLAT

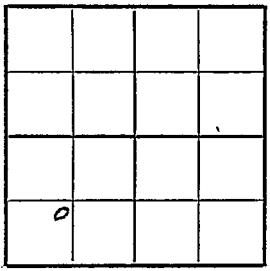

BARRY POOL

Location

Rig up

Drilling and Remarks:

RECORD

Cased in., ft.

Sand

Gas

Oil

Total Depth 250

PRODUCTION

1st 24 hrs. Nat.

1st 24 hrs. after shot

Gas Cu. Ft.

Dry Hole

Abandoned

Date

MAR 3 1 1943 19 S. I. LEWIS Scout