FORM 51 IOM 12-46 PETROL


KANSAS Rooks county

Section 1 Township 9 Range 19-W

Well No. #4 Gick

Company Continental

//

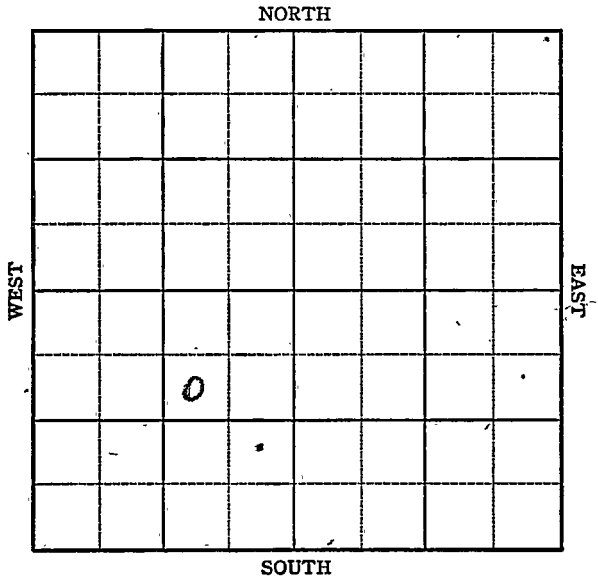

FORM 252-A
5M 12-45 PETROL

KANSAS

Rooks

Sec. 1 Twp. 9 R. 19-W

Well No. #4 Gick Farm

Continental Company

Barry Pool


990 Ft. from N. Line

Ft. from S. Line

990 Ft. from E. Line

Ft. from W. Line

SW NE SW

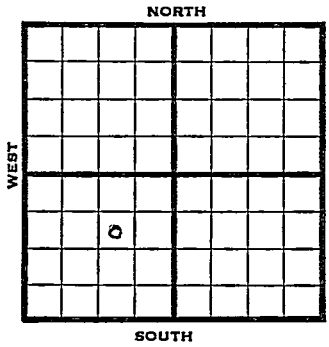

1947	2038 REPORT
1/29	Location
2/5	Location
2/12	Dirrick
2/19	10" @ 249 WOC
2/26	Arb 3464 -67 TD 3467' 6" @ 3465' RUST
3/4	TD 3475' 1000 Acid Pump 35 bbls oil PH 3 hrs
3/12	Arb 3464 6" @ 3465 1000 Acid Pump 559 Pot TD 3475'

COMPLETED

Form 26 200 Bks. 10-46 Petrol Kansas

KANSAS Barry Pool

Map No. 65 Sec. 1 Twp. 9 R. 19W

Well No. 4 Gick

Continental Company

FIRST REPORT Contractor

SW NE SW


SECTION PLAT

990 Ft. from N. Line

Ft. from S. Line

990 Ft. from E. Line

Ft. from W. Line

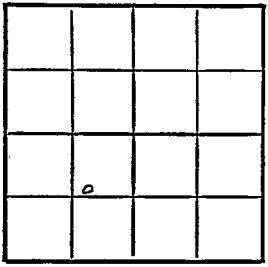

Rooks County

Location x

Rig up

Drilling and Remarks:

RECORD

Cased in., ft.

Sand

Gas

Oil

Total Depth

PRODUCTION

1st 24 hrs. Nat.

1st 24 hrs. after shot

Gas Cu. Ft.

Dry Hole

Abandoned

Date

JAN 29 1947 19

S. J. LEWIS Scout

Form 26 200 Bks. 10-46 Petrol

Barry Pool

Kansas

Map No. 5 Sec. 1 Twp. 9 R. 19W

Well No. 4 Gick

Continental Company

COMPLETE Contractor

SW NE SW

E 1.2058.


SECTION PLAT

990 Ft. from N. Line

Ft. from S. Line

990 Ft. from E. Line

Ft. from W. Line

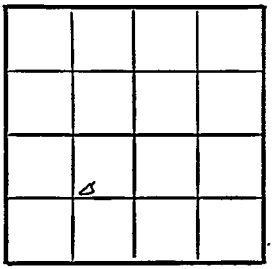

Rooks County

Location

Rig up

Drilling and Remarks:

Cir 3464

6" @ 3465

1000 acid

Pmp 50 BO

27 Gr

RECORD

Cased in., ft.

Sand

Gas

Oil

Total Depth 3475

PRODUCTION

1st 24 hrs. Nat.

1st 24 hrs. after shot

Gas Cu. Ft.

Dry Hole

Abandoned

Date

MAR 12 1947 19

S. J. LEWIS Scout