


Section 1 Township 9 Range 19 W

Well No. #6 Gick

Company Continental

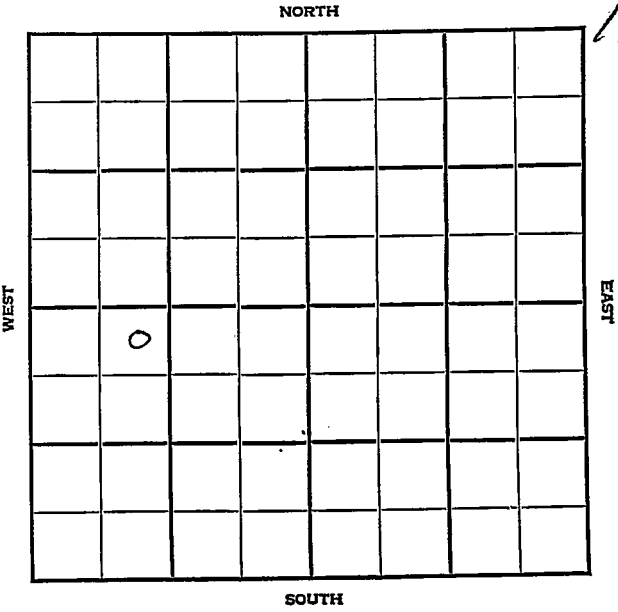

12

Sec. 1 Twp. 9 R. 19W

Well No. #6 Gick Farm _____

Continental

Barry Pool Company _____


330' Ft. from N. Line

_____ Ft. from S. Line

_____ Ft. from E. Line

990' Ft. from W. Line

NE NW SW

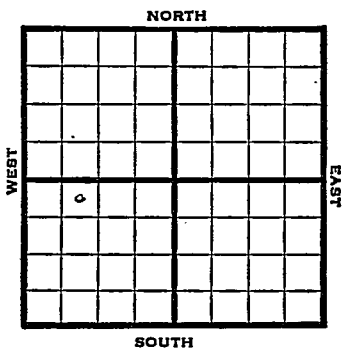

1948

Elev. 2027' REPORT

6/23 Location

6/29 "

7/8 Derrick

8/11 "

7/21 10" @ 204'
Drlg 2135'

7/28 Lansing 3184'
Arb. 3450'-54'
TD 3454'
6" @ 3451'
RUST

8/4 TD 3455'
Swab 25 bbls. oil PH 6 hrs.
500 acid.

8/11 Arbuckle 3450'
5" @ 3451'
TD 3455'
500 acid
Echo Pot. 3000 oil
Gr. 27°

COMPLETED

Map No. _____ Sec. 1 Twp. 9 R. 19W

Well No. 6 Gick

Continental Company

FIRST REPORT Contractor

NE NW SW

330 Ft. from N. Line

_____ Ft. from S. Line

_____ Ft. from E. Line

990 Ft. from W. Line

SECTION PLAT

o			

Rooks County

Location X

Rig up _____

Drilling and Remarks:

RECORD

Cased _____ in., _____ ft.

Sand _____

Gas _____

Oil _____

Total Depth _____

PRODUCTION

1st 24 hrs. Nat. _____

1st 24 hrs. after shot _____

Gas _____ Cu. Ft.

Dry Hole _____

Abandoned _____

Date

JUN 23 1948 19

S. J. LEWIS Scout

Rooks County Kansas State

Map No. 65 Sec. 1 Twp. 9 R. 19W

Well No. 6 Gick

Continental Company

COMPLETE Contractor

NE NW SW

E12027
SECTION PLAT

330 Ft. from N. Line

_____ Ft. from S. Line

_____ Ft. from E. Line

990 Ft. from W. Line

Barry Pool

Remarks:

Cur 83450

6" @ 3451

7123455

500 acid

E. C. L. P. 83000 oil.

27°/hr.

Date
AUG 11 1948

Scout
S. J. LEWIS