

KANSAS

FORM 51 5M BR1X

Rooks County

Section 1 Township 9 Range 19W

Well No. #1 J. Slansky "A"

Company Continental

NORTH

C							

WEST

EAST

SOUTH

5

Sec. 1 Twp. 9 R. 19W

Well No. #1 J. Slansky "A" Farm

Continental Company


Barry

_____ Ft. from N. Line

330 Ft. from S. Line

_____ Ft. from E. Line

330 Ft. from W. Line

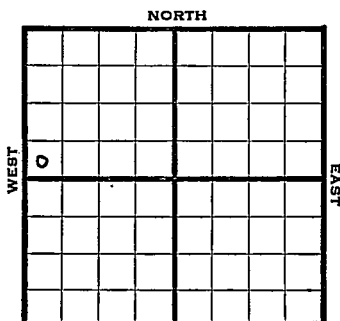

May. 2022

SW NW

1944

REPORT


7/12	Loc.
7/19	10" @ 241 Drlg 1420
7/26	Lans 3188 Show oil 3367-71, 3433-41 Arb. 3761 TD 3473 Run 6"
8/2	TD 3476 6" @ 3463 RUST
8/9	Drlg. 3520
8/16	3520 TD PB 3450 48 shots 3430-31 bail $\frac{1}{2}$ oil per hr.
8/23	1500 acid squeeze Perf.
8/30	Arb. 3466 3461 6" @ 3476 Lans 3188 PB 3380 Perf. Lans 2000acid Wtr TD 3478

ABANDONED

Pool Name BarryMap No. KAN 233 Sec. 1 Twp. 9 R. 19WWell No. 1 J. Slansky "A"Continental CompanyFIRST REPORT Contractor

SW NW

SECTION PLAT

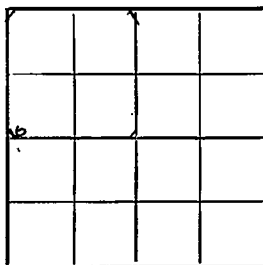 Ft. from N. Line330 Ft. from S. Line Ft. from E. Line330 Ft. from W. Line

Rooks County

Location XRig up

Drilling and Remarks:

RECORD

Cased in., ft.Sand Gas Oil Total Depth

PRODUCTION

1st 24 hrs. Nat. 1st 24 hrs. after shot Gas Cu. Ft.Dry Hole Abandoned

Date

JUL 12 1944

19

S. J. LEWIS Scout

