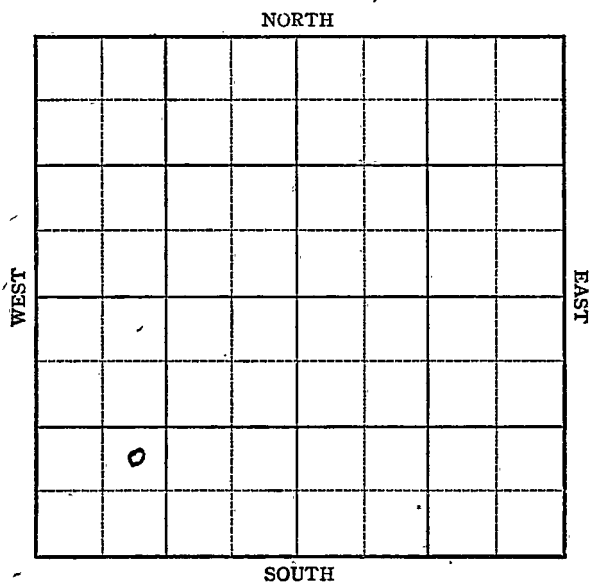


KANSAS

Rooks county
Barry Pool.Section 1 Township 9 Range 19WWell No. 5 JickCompany Continental13

KANSAS

Rooks

Sec. 1 Twp. 9 R. 19-W

Well No. #5 Jick Farm


Continental Company
Barry Pool

 Ft. from N. Line

990 Ft. from S. Line

 Ft. from E. Line

990 Ft. from W. Line

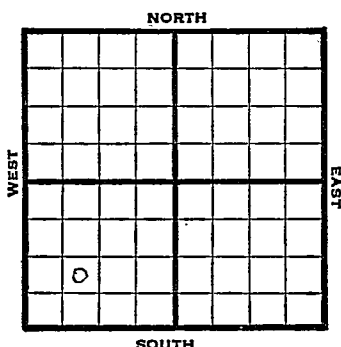

NE SW SW

1947 Elev. 2039' REPORT

4/16 10" @ 240'
Drlg 1906'

4/23 Arb 3454 -66
TD 3466'
6" @ 3465'
RUST

4/29 " "

5/7 Arb 3464
6" @ 3465'
1500 Acid
Echo Pot 3000
TD 3474'

COMPLETED

Kansas

Map No. K 65 Sec. 1 Twp. 9 R. 19WWell No. 5 JickContinental

Company

FIRST REPORT

Contractor

NE SW SW

SECTION PLAT

Ft. from N. Line

990 Ft. from S. Line

Ft. from E. Line

990 Ft. from W. LineTwin
Rooks County

Location

Rig up

Drilling and Remarks:

10" @ 240

drlg. 1906

RECORD

Cased _____ in., _____ ft.

Sand _____

Gas _____

Oil _____

Total Depth _____

PRODUCTION

1st 24 hrs. Nat. _____

1st 24 hrs. after shot _____

Gas _____ Cu. Ft.

Dry Hole _____

Abandoned _____

Date

APR 16 1947 19

S. J. LEWIS Scout

Kansas

Barry Pool

Map No. 465 Sec. 1 Twp. 9 R. 19WWell No. 5 JickContinental

Company

COMPLETE

Contractor

NE SW SW

E 1,2089

SECTION PLAT

 Ft. from N. Line990 Ft. from S. Line Ft. from E. Line990 Ft. from W. Line

Rooks County

Location Rig up

Drilling and Remarks:

Per 3464
6" 3465
1500000
Ech 3000

RECORD

Cased in, ft.Sand Gas Oil Total Depth 3474

PRODUCTION

1st 24 hrs. Nat. 1st 24 hrs. after shot Gas Cu. Ft.Dry Hole Abandoned

Date

MAY 7 1947 19 S. J. LEWIS Scout