


Company Continental

Barry Pool
NORTH

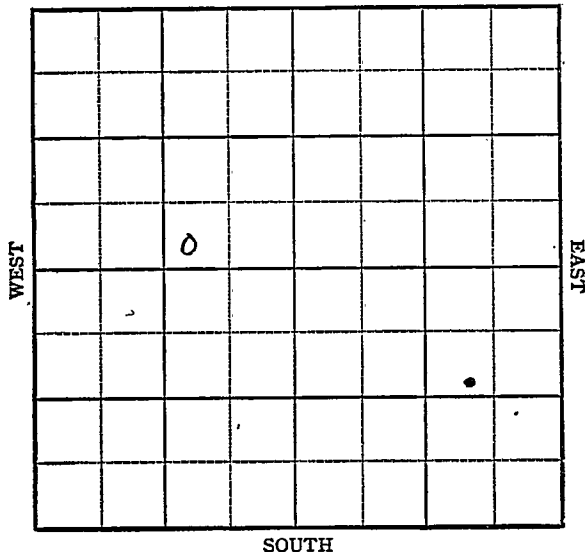

Sec. 1 Twp. 9 R. 19-W

Well No. #1 Slansky "C" Farm

Continental Company


 Ft. from N. Line

330 Ft. from S. Line.

990 Ft. from E. Line

 Ft. from W. Line

SW SE NW

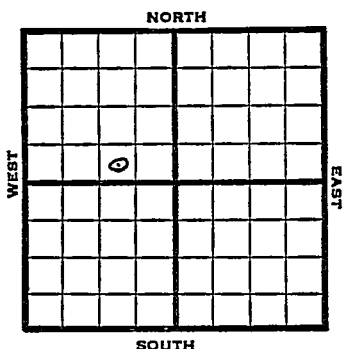

1948

Eli 2025'

R E P O R T

11/3

RUR

11/10

Drlg. 2127'

11/16

Lansing 3190'
Arbuckle 3458'
TD 3460'
5" @ 3458'

11/23

TD 3465'

11/30

42 shots 3451-65
2000 acid
Swb 26 bbls oil 24 hrs.

12/8

TD 3465'
Arb 3458'
7"@ 3459'
2000 acid
Pump 76 Oil Pot
30⁰ Gr.
Comp

COMPLETED


Map No. _____ Sec. 1 Twp. 9 R. 19WWell No. 1 Slansky "C"

_____ Continental. _____ Company

FIRST REPORT

_____ Contractor

SW SE NW

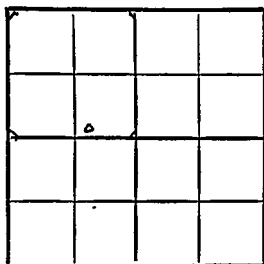SECTION PLAT

_____ Ft. from N. Line

330 _____ Ft. from S. Line990 _____ Ft. from E. Line

_____ Ft. from W. Line

Rooks County

Location _____

Rig up _____

Drilling and Remarks:

R U R

RECORD

Cased _____ in., _____ ft.

Sand _____

Gas _____

Oil _____

Total Depth _____

PRODUCTION

1st 24 hrs. Nat. _____

1st 24 hrs. after shot _____

Gas _____ Cu. Ft.

Dry Hole _____

Abandoned _____

Date

NOV 3 1948 19

S. J. LEWIS

Scout

65 Kansas

Map No. 25 Sec. 1 Twp. 9 R. 19WWell No. 1 Slansky "C"

Continental

Company

COMPLETE

Contractor

SW SE NW

E. 2025
SECTION PLAT

Ft. from N. Line

330

Ft. from S. Line

990

Ft. from E. Line

Ft. from W. Line

Rooks County

Location

Rig up

Drilling and Remarks:

Cert 3408

7" @ 3459

2000 acid

Pump 76 oil

(30) 2 1/2

RECORD

Cased _____ in., _____ ft.

Sand _____

Gas _____

Oil /Total Depth 3465

PRODUCTION

1st 24 hrs. Nat. _____

1st 24 hrs. after shot _____

Gas _____ Cu. Ft.

Dry Hole _____

Abandoned _____

Date

DEC 8 1948

19

S. J. LEWIS Scout