


Section 1 Township 9 Range 21W

Well No. #1 St. Peter

Company Jones, Shelborne & Farmer

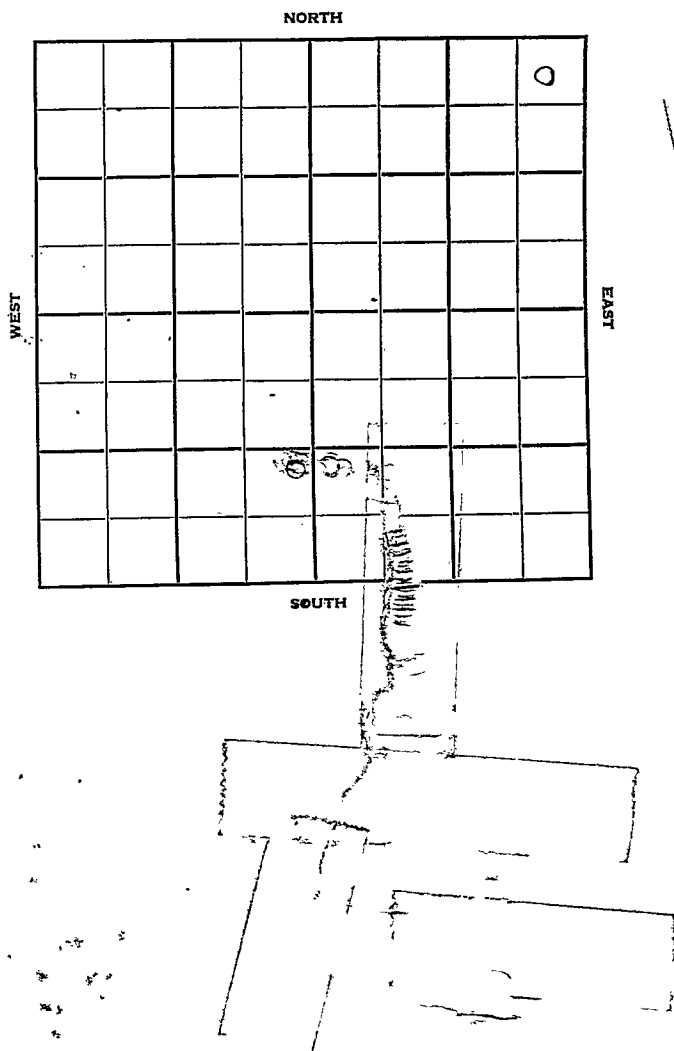

Graham

KANSAS

Sec. 1 Twp. 9 R. 21W

Well No. #1 St. Peter Farm

Jones, Shelborne & Farmer Company

Speer Drlg. - Contr. Contractor

Wildcat


330' Ft. from N. Line

 Ft. from S. Line

330' Ft. from E. Line

 Ft. from W. Line

NE NENE

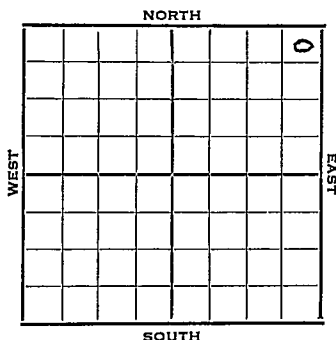

1951 Elev. 2091' REPORT

12/12 MIR

1952
1/2 Spud 12-11-51
D&A TD 3757
8" @ 160
Anhy 1620
Tor. 3332
Cong. 3675
TD 3757
D&A

Heeb. 3312
Lans. 3351
Arb. 3727

ABANDONED


J. E. TYRA

County Graham State Kansas
 Sec. 1 (Blk. Twp.) 9 (Sur. Rge.) 21W Map No.

Operator Jones, Shelborne & Farmer

Well No. 1 Farm St. Peter

Elev. 2091 Location NE NE NE

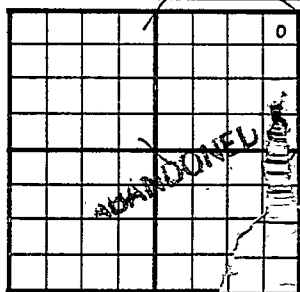

330 Ft. From N Line NE

330 Ft. From E Line Quarter

1st. Report

Completion JAN 2 1952

Remarks Wildcat

Speer Drlg. - Contr.

Spudding Date 12-11-51

Drig. Data D & A TD 3757

8" @ 160 Anhy 1620 Heeb. 3312

Tor. 3332 Lans. 3351 Cong. 3675

Arb. 3727 TD 3757

D & A

J. E. TYRA