

KANSAS

Graham

Section 1 Township 9 Range 24W

Well No. 1 Engelman


Company B & R & Wilcox

Wildcat

NORTH

WEST

EAST

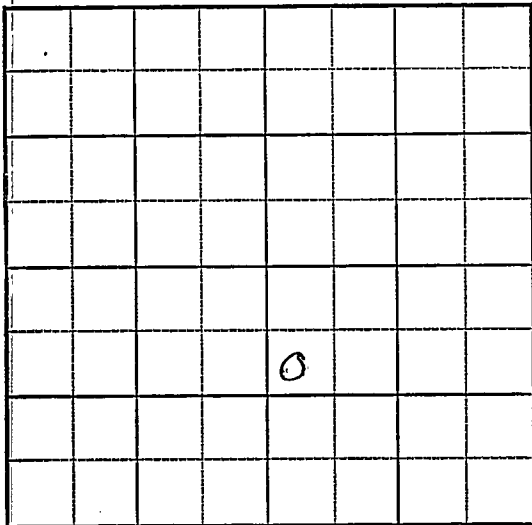

SOUTH

KANSAS

Graham ✓

Sec. 1 Twp. 9 R. 24W

Well No. 1 Engelman Farm

B & R & Wilcox Company


Wildcat

990 Ft. from N. Line

\_\_\_\_\_ Ft. from S. Line

\_\_\_\_\_ Ft. from E. Line

330 Ft. from W. Line

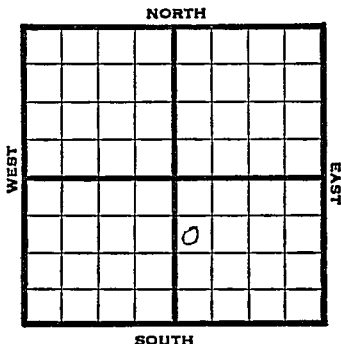

SW NW SE

1948

Eli 2435'

REPORT

9/1

8" @ 186'

Drlg. 1460'

9/8

Lansing 3725'

rfg 3810'

9/15

Lansing 3720'

Miss 4157'

Arb. 4391'

TD 4455'

Aband.

**ABANDONED**

4391  
3720  
-----  
671

4391  
2435  
-----  
1956

Graham County Kansas State

Map No. \_\_\_\_\_ Sec. 1 Twp. 9 R. 24W

Well No. 1 Engelman

B & R & Wilcox Company

**FIRST REPORT**

Contractor

SW NW SE

**SECTION PLAT**


990 Ft. from N. Line

\_\_\_\_\_ Ft. from S. Line

\_\_\_\_\_ Ft. from E. Line

330 Ft. from W. Line

②

Wildcat

Remarks:

8" @ 186 drlg. 1460'

Date  
SEP 1 1948

Scout **S. J. LEWIS**

