


Section 1 Township 9 Range 25W

Well No. #1 Clark "B"

Company Empire Drlg.

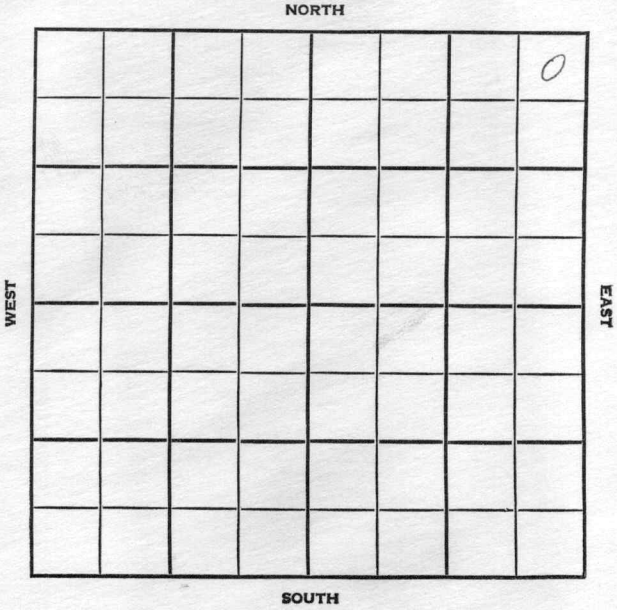

SEC.	TWP.	R.
1	9	25W

WELL NO. #1 Clark "B" FARM

COMPANY Empire Drlg.

CONTRACTOR Co. Tools

W. Holley


\_\_\_\_\_ FT. FROM N. LINE

\_\_\_\_\_ FT. FROM S. LINE

\_\_\_\_\_ FT. FROM E. LINE

\_\_\_\_\_ FT. FROM W. LINE

NE NE NE

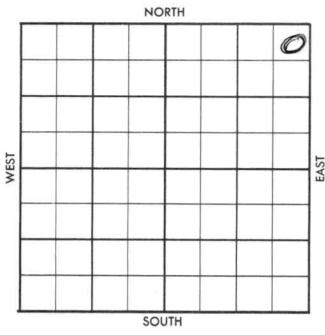

1956	ELEVATION 2472 DF	REPORT
------	-------------------	--------

7-11 Comm. 7-3-56  
 8" @ 175 w/115  
 DST 3958-75 op 1 hr, rec. 30' OCM,  
 210/15".  
 Drlg. 3975'  
 H. 3771'

7-18 D & A  
 L. 3812'  
 TD 3995'

**ABANDONED**

County Graham Elev. \_\_\_\_\_  
 Sec. 1 Twp. 9 Rgs. 25W  
 Company Empire Drlg.  
 Farm Name Clark "B" No. 1

TOPS	DEPTH	LOG	DATUM
Anh.			
T.P.			
H.	3771		
Tr.			
Dg.			
Bl.			
L.			
K.C.			
B.K.C.			
Ce.			
C.			
M.			
M.			
K.			
Mz.			
Ma.			
V.			
S.			
S.			
A.			
R.			
Pc.			
G.			
T.D.			

Loc. in Sec. NE NE NE  
 Geol. \_\_\_\_\_  
 Contr. Co. tools  
 Pool W. Holley  
 FIRST REPORT  
 JUL 1 '56

Date Comm. 7-3-56  
8" @ 175/115 OST 3958-75 open 1 hr.  
rec. 30' ocm 210/15" drlg. 3975

JUL 1 1956

R.G.

Co.  
L.se.  
No.  
Sec.  
T.  
R.

Co.

Loc.

No.

Sec.

T.

R.

County Graham Elev. 2472 DF  
 Sec. 1 Twp. 9 Rge. 258  
 Company Empire Drls.  
 FarmName Clark "B" No. 1

TOPS	DEPTH	LOG	DATUM	Loc. in Sec.
Anh.				NE 1/4 NE
Tp.				
H.	3771			
Tr.				
Dg.				
Bl.				
L.	3812			Geol.
K.C.				Contr.
B.K.C.				Co. tools
Ce.				
C.				
M.				Pool
M.				W. Holley
K.				
Mz.				
Ma.				
V.				
S.				
S.				
A.				ABANDONED
R.				JUL 18 1956
Pe.				
G.				
T.D.	3995			

Date Comm. 7-3-56  
8" @ 175/115 DST 3958-75 open 1 hr.  
rec. 30' ocm 210/15" drly. 3975

JUL 18 '56

*DEA*