

Section 1 Township 9 Range 25WWell No. #1 Stober est.Company Prime Drlg.

NORTH

0							

WEST

EAST

SOUTH

Graham

KANSAS

Sec. 1 Twp. 9 R. 25 W ✓

Well No. # 1 Stober est. Farm

P rime Drlg. Company

Wildcat Contractor


Ft. from N. Line

330 Ft. from S. Line

Ft. from E. Line

330 Ft. from W. Line

SW SW NW

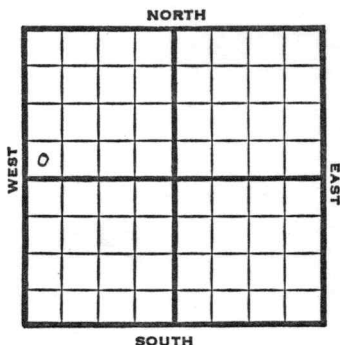


1951

Elev. 2520' REPORT

10/10
12/12

Location
Spud 10-9-51
Oil Well TD 4058
8" @ 245
Anhy 2215 Heeb. 3798
Tor. 3822 Lans. 3838
DST 3912-36 open 1 hr.
Rec. 60' wtr. & OCM 90' SW
DST 4002-21 open 1 hr. Rec. 2000'
oil
DST 4025-58 open 1 hr. rec. 4' mud
Marm. 4048-58
5" @ 4058 24/ 4013-17 S/ 12 BOPH
1000 A S/ 60 BO 1 hr.
Comp. BHB 1070 BOPD

COMPLETED

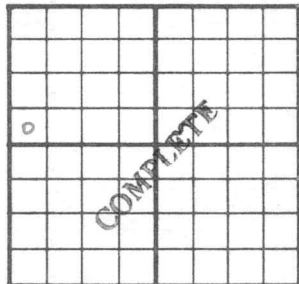County Graham State KansasSec. 1 (Blk.) 9 (Sur.) 25W Map No.Operator Prime Drlg.Well No. 1 Farm Stober Est.Elev. 2520 Location SW SW NW330 Ft. From S Line NW330 Ft. From W Line Quarter

1st. Report

Completion DEC 1 2 1951Remarks WildcatSpudding Date 10-9-51Drlg. Data Oil well TD 40588" @ 245 Anhy 2215 Heeb. 3798Tor. 3822 Lans. 3838 DST 3912-36open 1 hr. Rec. 60' water & ocm 90' swDST 4002-21 open 1 hr. Rec. 2000' oilDST 4025-58 open 1 hr. Rec. 4' mudMarm. 4048-58 5" @ 4058 24/ 4013-17S/ 12 boph 1000 A S/ 60 bo 1 hr.Comp. BHB 1070 bopd

J. E. TYRA