

KANSAS


Form 51-5M-7-40-Palace

Rooks

Section 10 Township 9 Range 16-W

Well No. #4 Breadmore

Company Co-OP

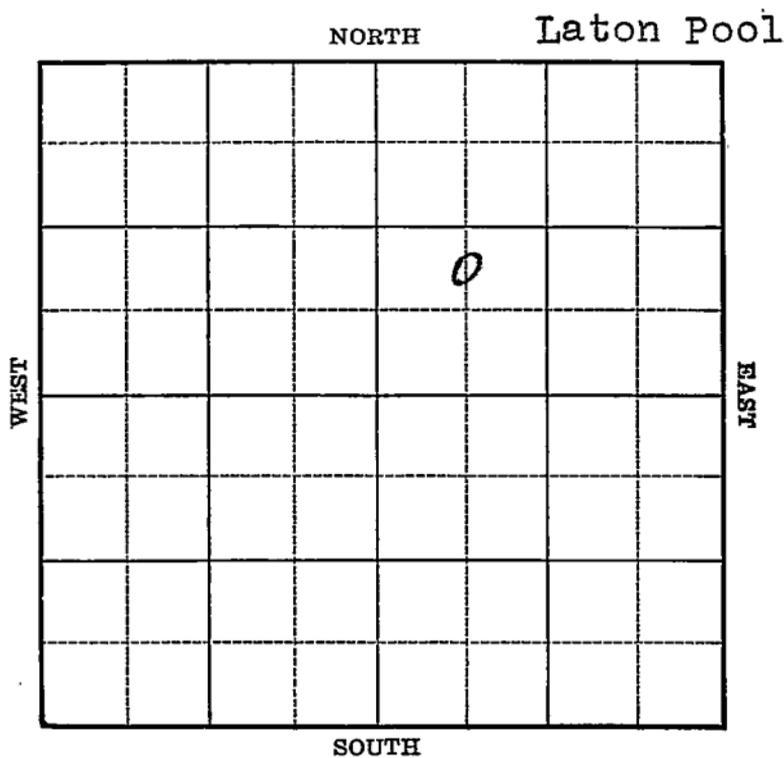

Sec. 10 Twp. 9 R. 16-W

Well No. #4 Beardmore Farm _____
Co-Op Company _____

(Laton)


_____ Ft. from N. Line

990 Ft. from S. Line

_____ Ft. from E. Line

660 Ft. from W. Line

Elev. 2016

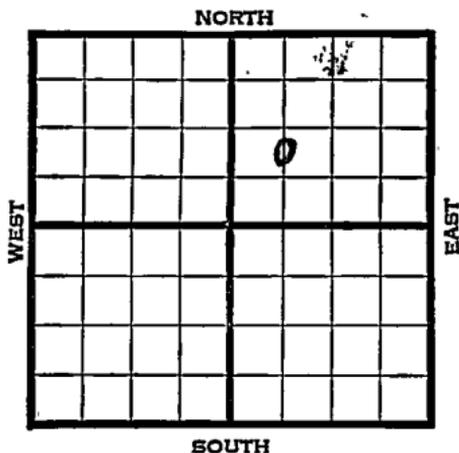

1940:	REPORT
10/23	Location
10/31	Anhy. 1263' Drlg. 2400'
11/7	Lans. 3149' 5" @ 3167'
	RUST.
11/14	Storm.
	Shut down.
11/20	T.D. 3215'
	Depth. Pot. 6223.
11/26	Lans. 3149'
	5" - 3167'
	T.D. 3215'
	8000 acid.
	Depthograph potential 6223 bbls.
	Maximum 3000 bbls.
	Gravity 32.4
	COMPLETED

Map No. 64 Sec. 10 Twp. 9 R. 16WWell No. 4 BeardmoreC6-Op Company

Contractor

FIRST REPORT**SECTION PLAT**

C N L SW NE

 Ft. from N. Line990 Ft. from S. Line Ft. from E. Line660 Ft. from W. Line

		o	

LATON POOL

Location XRig up

Drilling and Remarks:

RECORDCased in., ft.Sand Gas Oil Total Depth **PRODUCTION**1st 24 hrs. Nat. 1st 24 hrs. after shot Gas Cu. Ft.Dry Hole Abandoned

Date

OCT 23 1940 19S. J. LEWIS Scout

