

KANSAS

Rooks


Form 51-5M-7-40-Palace

Section 10 Township 9 Range 16-W

Well No. #5 Beardmore

Company Co-op

NORTH Laton Pool

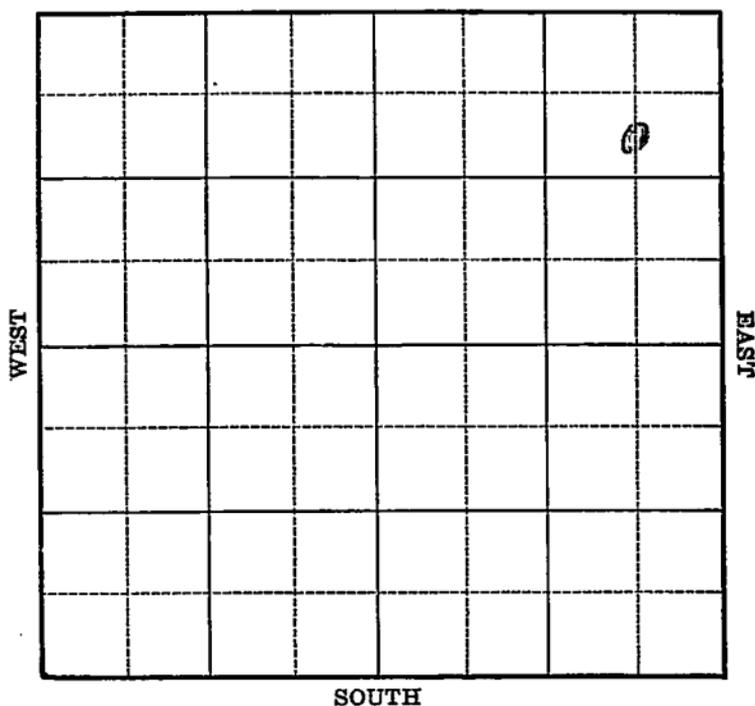

Map No. 64 Sec. 10 Twp. 9 R. 16WWell No. 5 Beardmore

Co-op.

Company

Contractor

FIRST REPORT

C S L NE NE

990 Ft. from N. Line

_____ Ft. from S. Line

660 Ft. from E. Line

_____ Ft. from W. Line

SECTION PLAT

			o

LATON POOL

Location _____

Rig up _____

Drilling and Remarks:

S.H.

RECORD

Cased _____ in., _____ ft.

Sand _____

Gas _____

Oil _____

Total Depth _____

PRODUCTION

1st 24 hrs. Nat. _____

1st 24 hrs. after shot _____

Gas _____ Cu. Ft.

Dry Hole _____

Abandoned _____

Date

NOV 6 1940

19

S. J. LEWIS

Scout

Map No. 64 Sec. 10 Twp. 9 R. 16WWell No. 5 Beardmore

Co-op. _____ Company

Contractor _____

COMPLETED

C S L NE NE

990 Ft. from N. Line

_____ Ft. from S. Line

660 Ft. from E. Line

_____ Ft. from W. Line

SECTION PLAT

LATON POOL

Location _____

Rig up _____

Drilling and Remarks:

*Loss 3/25**5" C 3/45**9000 Acid**Dep. The P & 2327**38² Gr***RECORD**

Cased _____ in., _____ ft.

Sand _____

Gas _____

Oil _____

Total Depth 3197**PRODUCTION**

1st 24 hrs. Nat. _____

1st 24 hrs. after shot _____

Gas _____ Cu. Ft.

Dry Hole _____

Abandoned _____

Date

DEC 30 1940 19

S. J. LEWIS Scout