


Section 10 Township 9 Range 16-W

Well No. #7 Beardmore

Company Co-op.

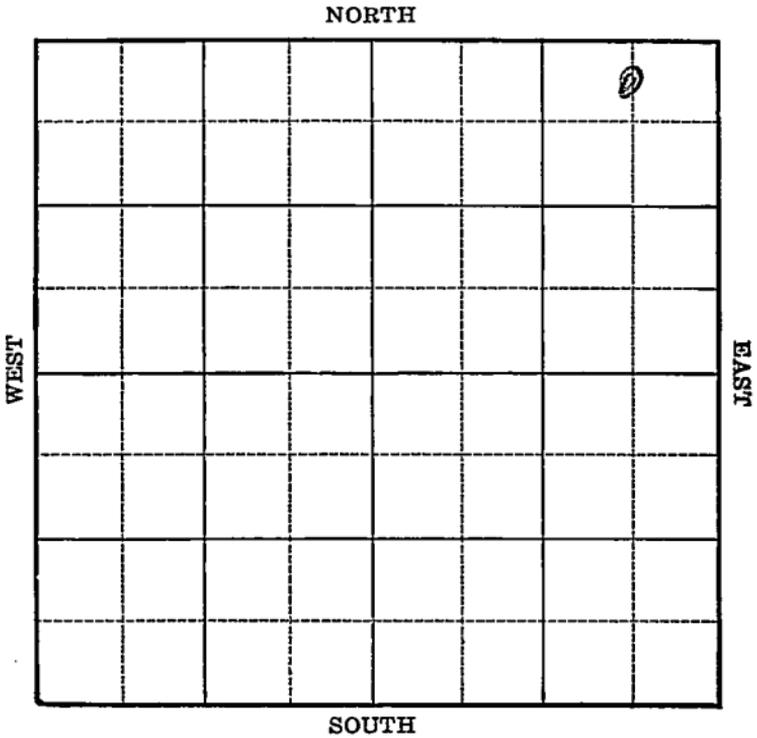



Map No. 64 Sec. 10 Twp. 9 R. 16WWell No. 7 Beardmore

Co-op. \_\_\_\_\_ Company \_\_\_\_\_

Contractor \_\_\_\_\_

**FIRST REPORT**

C N L N E N E

**SECTION PLAT**330 Ft. from N. Line

\_\_\_\_\_ Ft. from S. Line

660 Ft. from E. Line

\_\_\_\_\_ Ft. from W. Line

			o

LATON POOL

Location X

Rig up \_\_\_\_\_

Drilling and Remarks:

**RECORD**

Cased \_\_\_\_\_ in., \_\_\_\_\_ ft.

Sand \_\_\_\_\_

Gas \_\_\_\_\_

Oil \_\_\_\_\_

Total Depth \_\_\_\_\_

**PRODUCTION**

1st 24 hrs. Nat. \_\_\_\_\_

1st 24 hrs. after shot \_\_\_\_\_

Gas \_\_\_\_\_ Cu. Ft.

Dry Hole \_\_\_\_\_

Abandoned \_\_\_\_\_

Date

DEC 30 1940 19S. J. LEWIS Scout

Map No. 64 Sec. 10 Twp. 9 R. 16WWell No. 7 Beardmore

Co-op. \_\_\_\_\_ Company

Contractor \_\_\_\_\_

**COMPLETED****SECTION PLAT**330 C N L NE NE  
Ft. from N. Line

\_\_\_\_ Ft. from S. Line

660 Ft. from E. Line

\_\_\_\_ Ft. from W. Line

LATON POOL

			o

Location \_\_\_\_\_

Rig up \_\_\_\_\_

Drilling and Remarks:

*have 3124  
5" @ 3145  
5000 cu ft  
Depth. P. 82576  
38° Br.*

**RECORD**

Cased \_\_\_\_\_ in., \_\_\_\_\_ ft.

Sand \_\_\_\_\_

Gas \_\_\_\_\_

Oil \_\_\_\_\_

Total Depth: 3192**PRODUCTION**

1st 24 hrs.-Nat. \_\_\_\_\_

1st 24 hrs. after shot \_\_\_\_\_

Gas \_\_\_\_\_ Cu. Ft.

Dry Hole \_\_\_\_\_

Abandoned \_\_\_\_\_

Date

JAN 29 1941<sub>19</sub>S. J. LEWIS Scout