
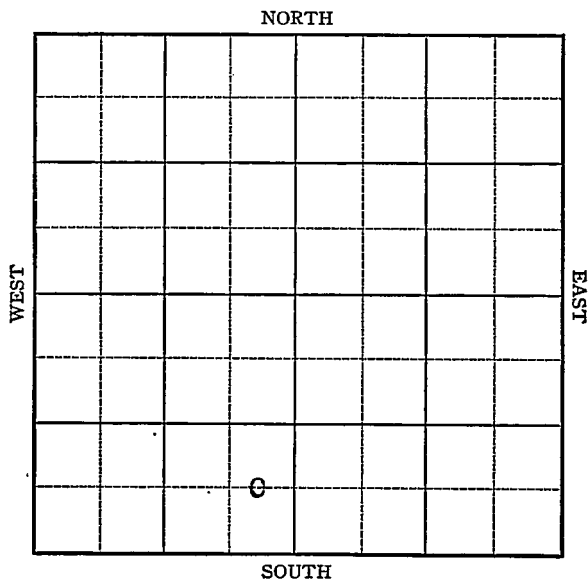


Section 10 Township 9 Range 16W

Well No. 3-Buell

Company Cities Service Oil

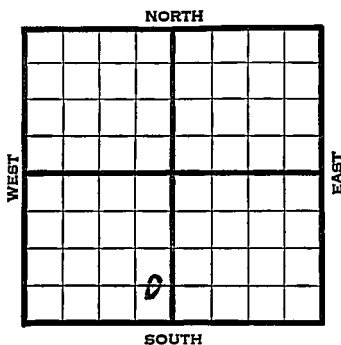

[illegible]

Map No. 64 Sec. 10 Twp. 9 R. 16WWell No. 3 Buell

City Service Oil Company

Contractor

FIRST REPORT

SECTION PLAT

C EL SE SW

Ft. from N. Line

660 Ft. from S. Line

330 Ft. from E. Line

Ft. from W. Line

LATON POOL

RECORD

Location

Cased in, ft.

Rig up

Sand

Drilling and Remarks:

Gas

8" @ 125 W.O.C.

Oil

Total Depth

PRODUCTION

1st 24 hrs. Nat.

1st 24 hrs. after shot

Gas Cu. Ft.

Dry Hole

Abandoned

Date

SEP 10 1941

S. J. LEWIS Scout

Map No. K-64 Sec. 10 Twp. 9 R. 16WWell No. 3 Buell

City Service Oil

Company

~~COMPLETED~~

Contractor

C EL SE SW

Ft. from N. Line

660 Ft. from S. Line330 Ft. from E. Line

Ft. from W. Line

SECTION PLAT

LATON POOL

Location

Rig up

Drilling and Remarks:

*Loss 3217**5' 0" 3220**3000 acid**Pump 160 oil & water**P.D.**38° Gr*

RECORD

Cased _____ in., _____ ft.

Sand _____

Gas _____

Oil _____

Total Depth 3270

PRODUCTION

1st 24 hrs. Nat. _____

1st 24 hrs. after shot _____

Gas _____ Cu. Ft.

Dry Hole _____

Abandoned _____

Date

SEP 24 1941

19

S. J. LEWIS

Scout