

KANSAS

Rooks


Form 51-5M-7-39-Palace

Section 10 Township 9 Range 16-W

Well No. #1 Lukman

Company T. C. Johnson

Laton Pool

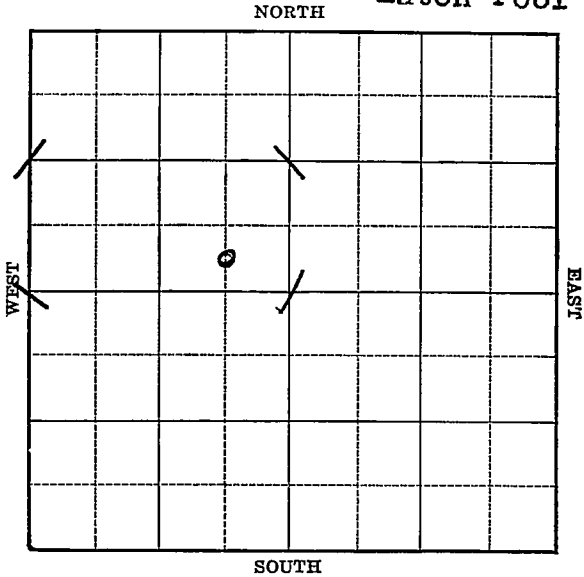

KANSAS Rooks

FORM 252-A 5M 2-40

Sec. 10 Twp. 9 R. 16-W

Well No. #1 Lukman Farm

T. C. Johnson Company

(Laton)


_____ Ft. from N. Line

330 Ft. from S. Line

660 Ft. from E. Line

_____ Ft. from W. Line

Elev. 2033

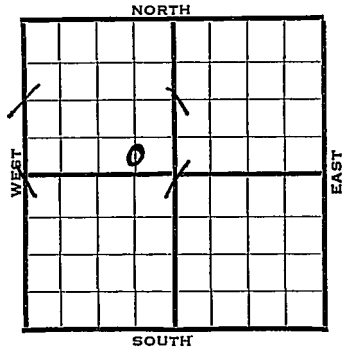

	REPORT
1940	
6/5	Derrick
	Rigging up.
6/13	10" - 43'
	Drlg. 225'
6/20	Topeka 2878' Lans. 3160' Drlg.
6/27	T.D. 3203' 7" - 3186' RUST.
	Show oil.
7/3	T.D. 3220' Swab 33.6 bbls. in
	24 hours.
7/10	7000 acid. Pump 161 bbls. 9½
	hours.
7/17	Lans. 3185'
	7" - 3186'
	T.D. 3220'
	7000 acid.
	Depthograph potential 2350 bbls.
	COMPLETED

Map No. 64 Sec. 10 Twp. 9 R. 16WWell No. 1 LukmanT. C. Johnson

Company

Contractor

FIRST REPORT

C S L SE NW

_____ Ft. from N. Line

330 Ft. from S. Line660 Ft. from E. Line

_____ Ft. from W. Line

SECTION PLAT

LATON POOL

Location _____

Rig up _____

Drilling and Remarks:

Derrick

Rigging up

RECORD

Cased _____ in., _____ ft.

Sand _____

Gas _____

Oil _____

Total Depth _____

PRODUCTION

1st 24 hrs. Nat. _____

1st 24 hrs. after shot _____

Gas _____ Cu. Ft.

Dry Hole _____

Abandoned _____

Date

JUN 5 1940 19S. J. LEWIS Scout

