

Rooks KANSAS

SEC.	TWP.	R.
10	9	17 W

WELL NO. # 1 Thompson FARM

COMPANY Murfin Drlg.


CONTRACTOR Co. tools

330 Semi-Wildcat Ft. from N. Line

Ft. from S. Line

Ft. from E. Line

330 Ft. from W. Line

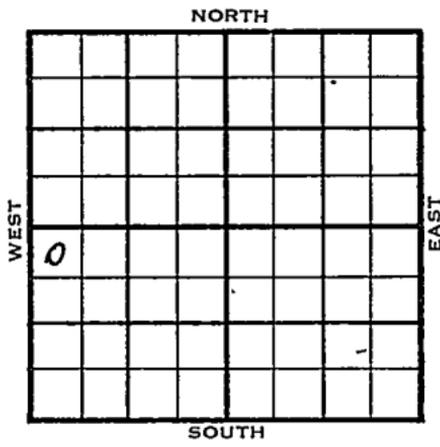

NW NW SW

1954	ELEVATION 2024'	REPORT
------	-----------------	--------

12/22 Spud 12-19-54
8" @ 180
Drlg. 2465'

1955
1/12 Spud 12-19-54
D & A
TD 3478'
8" @ 180'
Anhy 1314', Heeb 3139' Tor 3154'
Lans 3179'
DST 3372'-3424' opn 1 hr, rec 40' socm
715# Arb. 3462'
DST 3456'-68' opn 1/2 hr, rec 5' Mud 0#
DST 3205'-25' opn 1 hr, rec 8' Mud 610#
DST 3326'-66' opn 1/2 hr, rec 12' Mud
760#
TD 3478'
D & A

ABANDONED

County Rooks State Kansas

Sec. 10 (Blk. Twp.) 9 (Sur. Rge.) 17W Map No.

Operator Murfin Drlg.

Well No. 1 Farm Thompson

Elev. 2024 Location NW NW SW

330 Ft. From N Line SW

330 Ft. From W Line Quarter

Ist. Report DEC 22 1954

Completion _____

Remarks _____

Co. tools

Spudding Date 12-19-54

Drlg. Data Semi Wildcat

8" @ 180 drlg. 2465

