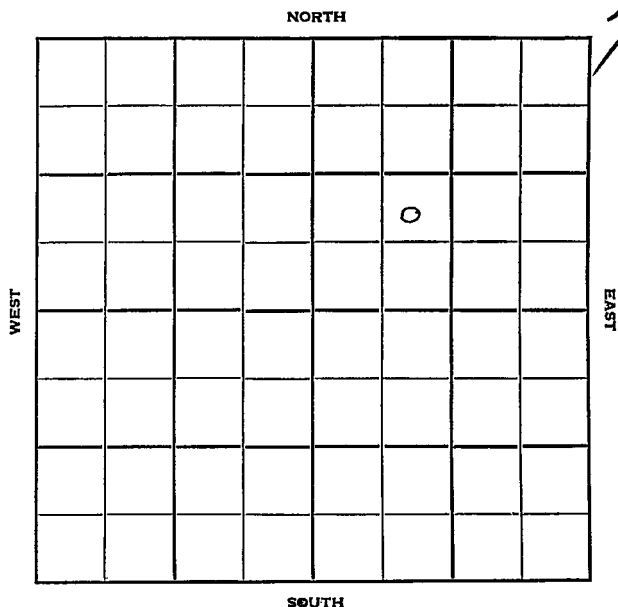


Section 10 Township 9 Range 19WWell No. #1 Barry "C"Company Continental Oil

Rooks

KANSAS

Sec. 10 Twp. 9 R. 19W

Well No. #4 Berry "C" Farm

Continental Oil Company

Lohman & Johnson - Contr. Contractor

Barry Pool


Ft. from N. Line

990' Ft. from S. Line

Ft. from E. Line

990' Ft. from W. Line

NE SW NE

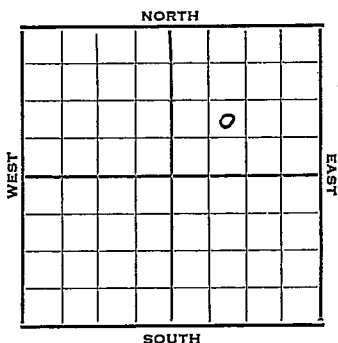

1951 Elev. 2055' REPORT

12/12 Spud 12-6-51
10" @ 193'
Drlg. 2265'

1952
2/6 Lans. 3237 Arb. 3478
7" @ 3479 TD 3488
S/ 30 BOPD

2/13 No report

2/20 "

3/5 Spud 12-6-51 10" @ 193
Lans. 3237 Arb. 3478
DST 3480-88 opn 1 hr. Rec. 30' mud
TD 3488 7" @ 3479 CO to 3488 500 A
B/1/8 bo 4 hrs. 1500 A B 1/3 bo
14/ bwph DD 3496 B 1/5 boph DD 3502
no inc. DD 3516 SSO PB 3444
22/3400-08 B/tr. oil 1/8 bwph 500 A
S/1/5 bo 1/5 bwph 1500 A s/ 1/6 bo
1/2 bwph PB 3390 12/3370-74
12/3300-04 B/1/7 boph 500 A
S/4 bw 1/7 boph DP to 3442
26/3428-38 S/4 bwph 1/3 boph 500 A
S/4 bw 1/3 boph SP 3290 18/3280-86
S/1/4 bwph 42/3236-50 s/1/4 bw tr. oil
ph 500 A S/3 1/2 bw 1 1/2 boph S/3 1/2 bw
1 1/2 boph SP 3270 S/1/4 boph S/30 bopd
Comp. 46 bopd 28 bw

COMPLETED

County Rooks State KansasSec. 10 (Blk. Twp.) 9 (Sur. Rge.) 19W Map No.Operator Continental OilWell No. 4 Farm Barry "C"Elev. Location NE SW NE

FIRST REPORT


990 Ft. From S Line NE990 Ft. From W Line Quarter1st. Report DEC 1 2 1951

Completion

Remarks

Lohman & Johnson - Contr.Spudding Date 12-6-51Drlg. Data Barry Pool10" @ 193 drlg. 2265J. E. TYRA

County Rooks State Kansas
 Sec. 10- (Blk.) 9 (Sur.) 19W Map No.
 Operator Continental Oil
 Well No. 4 Farm Barry "C"
 Elev. 2055 Location NE SW NE

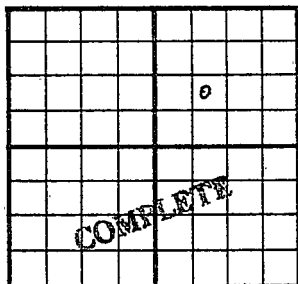

990 Ft. From S Line NE
990 Ft. From W Line Quarter
1st. Report
Completion MAR 5 1952
Remarks Barry Pool
Lohman & Johnson - Contr.
Spudding Date 12-6-51

Drig. Data Oil well TD 3516

10" @ 193 Lans. 3237 Arb. 3478

DST 3480-88 open 1 hr. Rec. 30' mud

TD 3488 7" @ 3479 CO to 3488 500 A

B/ 1/8 bo 4 hr. 1500 A B/ 1/3 bo

1/4 bwph DD 3496 B/ 1/5 boph DD 3502

no inc. DD 3516 SSO PB 3444

22/ 3400-08 B/ tr. oil 1/8 bwph 500 A

S/ 1/5 bo 1/5 bwph 1500 A S 1/6 bo

1/2 bwph PB 3390 12/ 3370-74

12/ 3300-04 B/ 1/7 boph 500 A S/ 4 bw

1/7 boph DP to 3442 26/ 3428-38

S/ 4 bwph 1/3 boph 500 A S/ 4 bw

1/3 boph SP 3290 18/ 3280-86 S/ 1/4 bwph

42/ 3236-50 S/ 1/4 bw tr. oil ph 500 A

J. G. McGEHEE

Drlg. Data

S/ $3\frac{1}{2}$ bw $1\frac{1}{2}$ boph S/ $3\frac{1}{2}$ bw $1\frac{1}{2}$ boph

SP 3270 S/ $\frac{1}{4}$ boph S/ 30 bopd

Comp. 46 bopd 28 bw

_____	Misc.
_____	Pierce Map
_____	France Map
_____	Tracings
_____	Land Wall Map
_____	Land Small Map
_____	Scout Cards

APR 10 1960