

Section 10 Township 9 Range 19-WWell No. #1 Rosocil (C)Company Sohio etal

NORTH

0							

SOUTH

4

WEST

EAST

Rooks KANSAS

Sec. 10 Twp. 9 R. 19W

Well No. #1 Rosocil (C) Farm

Sohio et al Company

Contractor


330' Ft. from N. Line

Ft. from S. Line

Ft. from E. Line

330' Ft. from W. Line

NW NW NW

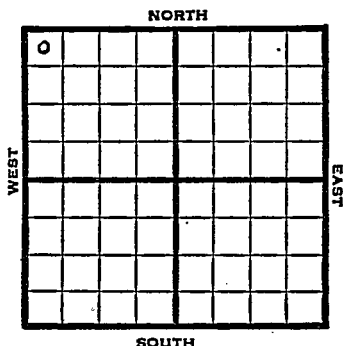

1950 Elev 2030 REPORT

5/17 3" @ 312'
WOC

6/28 Anhy 1435 Heeb 3170
Lans 3212
DST 3212-36, opn 30 min rec 35' mud
DST 3344-90 opn 1 hr rec 195' h₂O
DST 3404-20 opn 30 min rec 278' SW
Arb 3458-60
5" @ 3458
TD 3461
Bail 2 gal. oil $\frac{1}{2}$ gal wtr ph
S/6 bfph 13% wtr
Comp 87 bopd 10% wtr
Completed

COMPLETED

Map No. _____ Sec. 10 Twp. 9 R. 19WWell No. 1 Rosocil (C)Schio et al. Company

Contractor

NW NW NW

SECTION PLAT

330 Ft. from N. Line

_____ Ft. from S. Line

_____ Ft. from E. Line

330 Ft. from W. Line

0			
FIRST	REPORT		

Rooks

Location _____

Rig up _____

Drilling and Remarks:

3" @ 312

W. O. C.

RECORD

Cased _____ in., _____ ft.

Sand _____

Gas _____

Oil _____

Total Depth _____

PRODUCTION

1st 24 hrs. Nat. _____

1st 24 hrs. after shot _____

Gas _____ Cu. Ft.

Dry Hole _____

Abandoned _____

Date

MAY 17 1950

19

J. E. TYRA

Scout

Map No. _____ Sec. 10 Twp. 9 R. 19WWell No. 1 Rostocil "C"Sohio etal.

Company


Contractor

NW NW NW

E1. 2030
SECTION PLAT330 Ft. from N. Line

_____ Ft. from S. Line

_____ Ft. from E. Line

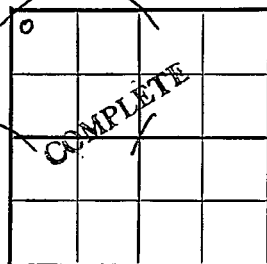330 Ft. from W. Line

Rooks County

Location _____

Rig up _____

Drilling and Remarks:

Anhy 1435

Heeb. 3170

Lans. 3212

DST 3212-36-

open 30 min.

Rec. 35' mud

RECORD

Cased _____ in., _____ ft.

Sand _____

Gas _____

Oil _____

Total Depth 3461

PRODUCTION

1st 24 hrs. Nat. _____

1st 24 hrs. after shot _____

Gas _____ Cu. Ft.

Dry Hole _____

Abandoned _____

Date

JUN 28 1950 19J. E. TYRA

Scout

DST 3344-90

open 1 hr.

Rec. 195' hoom

DST 3404-20

open 30 min

Rec. 278' of salt water

Arb. 3458-60

5" © 3458

TD 3461

Bail 2 gal. oil 1 gal. water ph

S/ 6 bfph 13% water

Comp 87 bopd 10% water

..... Misc.
..... Pierce Map
..... France Map
..... Tracings
..... Land Wall Map
..... Land Small Map
..... Scout Cards
