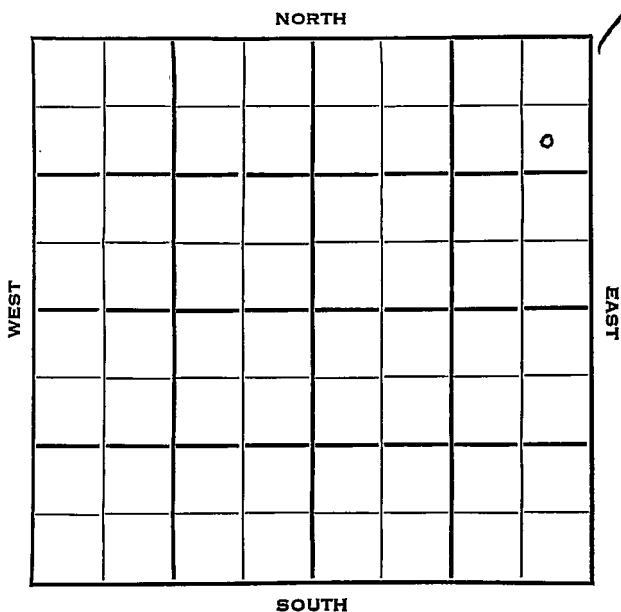


Section 10 Township 9 Range 19WWell No. #1 BerryCompany Jones, Shelburne & Farmer


Rooks		KANSAS
SEC.	TWP.	R.
10	9	19W
WELL NO.		
#1 Berry		FARM
COMPANY		
Jones, Shelburne & Farmer		
CONTRACTOR		
J-S-F		

990 Ft. from N. Line

Ft. from S. Line

330 Ft. from E. Line

Ft. from W. Line

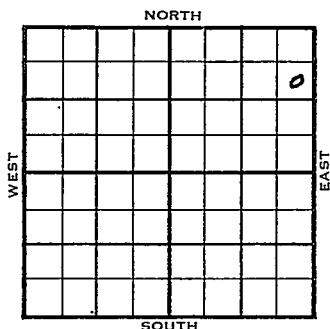


SE NE NE

	ELEVATION	REPORT
1954	2052'	
4/7		Cellar & Pits.
4/14		"
428		Spud 4-15-54
		D&A
		TD 3507'
		8" @ 163'
		Heeb 3193', Tor 3221', Lans 3237'
		DST 3279-97', opn $\frac{1}{2}$ hrs., rec. 6' mud,
		0#
		Arb. 3481'
		DST 3482-86', opn $\frac{1}{2}$ hrs., rec. 6' mud,
		0#
		DST 3487-90', opn $\frac{1}{2}$ hrs., rec. 15'
		mud, SS0, 900#
		TD 3507'
		D&A
		ABANDONED

J. G. McGEHEE

County _____ Rooks _____ State **Kansas**
 Sec. 10 (Blk. Twp.) 9 (Sur. Rge.) 19W Map No. _____
 Operator Jones, Shelburne & Farmer
 Well No. 1 Farm Berry
 Elev. 2052 Location SE NE NE

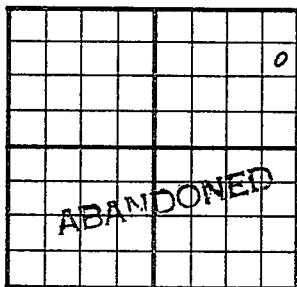

990 Ft. From N Line NE
 330 Ft. From E Line Quarter

1st. Report

Completion **APR 28 1954**

Remarks

J-S-F - Contr.

Spudding Date 4-15-54

Drig. Data D & A TD 3507

8" @ 163 Heeb. 3193 Tor. 3221

Lans. 3237 DST 3279-97 open $\frac{1}{2}$ hr.

Rec. 6' mud 0# Arb. 3481 DST 3482-

86 open $\frac{1}{2}$ hr. Rec. 6' mud 0#

DST 3487-90 open $\frac{1}{2}$ hr. Rec. 15' mud

SSO 900# TD 3507

D & A

J. G. McGEHEE