

KANSAS


FORM 51 5M BR1X

Rooks

Section 10 Township 9 Range 19W

Well No. #1 Dan Barry 11611

Company Continental

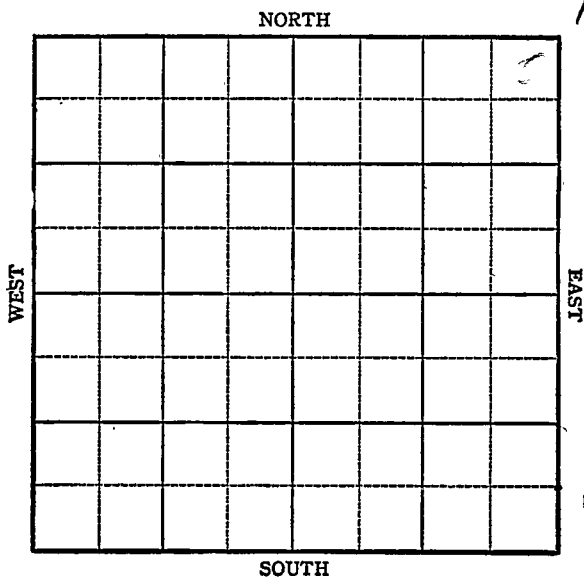

Rooks

Sec. 10 Twp. 9 R. 19W

Well No. #1 Dan Barry #C Farm

Continental Company


Barry

330 Ft. from N. Line

 Ft. from S. Line

330 Ft. from E. Line

 Ft. from W. Line

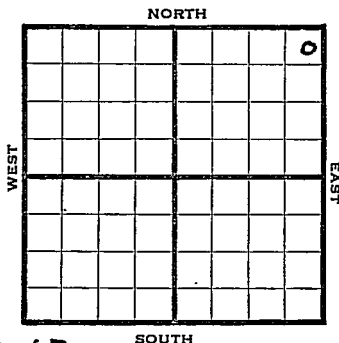

NE/c Allen. 2047

1944

REPORT

8/23	Location
8/30	Drk.
9/8	"
9/13	10" @ 241 Drlg. 22858
9/21	2987 fsg.
9/28	" "
10/4	Drlg. 3393
10/11	Arb 3467
	TD 3472
	6" @ 3468-1300 oil
10/18	500 acid swb 97 oil in 2 hrs.
10/25	" " " " " " " "
11/2	" " " " " " " "
11/8	" " " " " " " "
11/16	" " " " " " " "
11/24	" " " " " " " "
11/29	" " " " " " " "
12/6	" " " " " " " "
12/14	" " " " " " " "
12/21	" " " " " " " "
12/29	" " " " " " " "
1945	
1/3	" " " " " " " "
1/10	" " " " " " " "

OVER

1945

1/17

Arb 3467
6" @ 3468
500 acid
Depth Pot 2747
TD 3472
Grav. 28.0

COMPLETED

Pool Name BarryMap No. KANSAS 63 Sec. 10 Twp. 9 R. 19WWell No. 1 Dan Barry "C"Continental Company

FIRST REPORT

NE/C

Contractor


SECTION PLAT

330 Ft. from N. Line

Ft. from S. Line

330 Ft. from E. Line

Ft. from W. Line

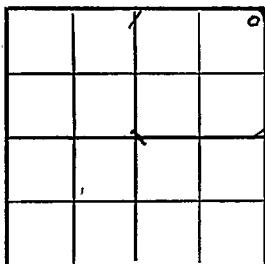Rooks CountyLocation X

Rig up

Drilling and Remarks:

RECORD

Cased _____ in., _____ ft.

Sand _____

Gas _____

Oil _____

Total Depth _____

PRODUCTION

1st 24 hrs. Nat. _____

1st 24 hrs. after shot _____

Gas _____ Cu. Ft.

Dry Hole _____

Abandoned _____

Date

AUG 23 1944 19 S. J. LEWIS Scout

Pool Name Barry PoolMap No. KANSAS Sec. 10 Twp. 9 R. 19WWell No. 1 Dan Barry "C"Continental CompanyCOMPLETED Contractor

NE/c

SECTION PLAT

			0

330 Ft. from N. Line Ft. from S. Line330 Ft. from E. Line Ft. from W. LineRooks CountyLocation Rig up

Drilling and Remarks:

*Per X. 3467**6" @ 3468**500 acid**Depth 2747**28° E*

RECORD

Cased in., ft.Sand Gas Oil Total Depth 2747

PRODUCTION

1st 24 hrs. Nat. 1st 24 hrs. after shot Gas Cu. Ft.Dry Hole Abandoned

Date

JAN 17 1945

19

S. J. LEWIS Scout