

KANSAS


Rooks County

FORM 51 5M BRIX

Section 10 Township 9 Range 19W

Well No. #2 Dan Barry "C"

Company Continental

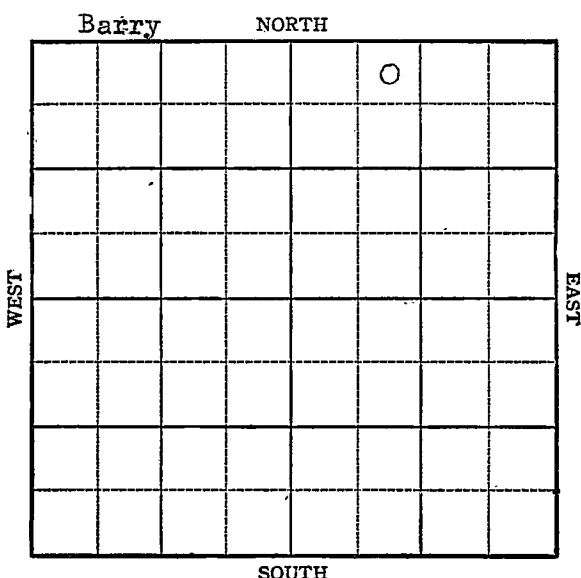

KANSAS

Rooks County

Sec. 10 Twp. 9 R. 19W


Well No. #2 Dan Barry "G" Farm

Continental

Company

Barry

NORTH

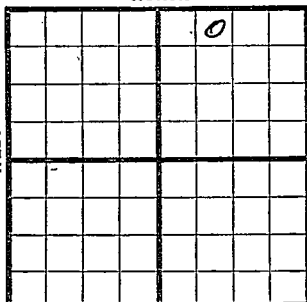

WEST

EAST

SOUTH

330 Ft. from N. Line

Ft. from S. Line

Ft. from E. Line

990 Ft. from W. Line

NE NW NE Elev. 2068

1944

R E P O R T

10/25 Derrick
11/2 10" @ 236
Drlg. 1480
11/8 Drlg. 3177
11/16 Arb 3644 drlg.
11/22 Arb 3644
TD 3717'

ABANDONED

Pool Name BarryMap No. KANSAS 10 Sec. 10 Twp. 9 R. 19WWell No. 2 Dan Barry "C"Continental

Company

FIRST REPORT

Contractor

NE NW NE

SECTION PLAT

330 Ft. from N. Line

Ft. from S. Line

Ft. from E. Line

990 Ft. from W. Line

		0	

Rooks County

Location

Rig up

Drilling and Remarks:

Derrick

RECORD

Cased _____ in, _____ ft.

Sand _____

Gas _____

Oil _____

Total Depth _____

PRODUCTION

1st 24 hrs. Nat. _____

1st 24 hrs. after shot _____

Gas _____ Cu. Ft.

Dry Hole _____

Abandoned _____

Date

OCT 25 1944 19S. J. LEWIS Scout

Pool Name BarryMap No. 65 Sec. 10 Twp. 9 R. 19WWell No. 2 Dan Barry "C"Continental

Company

ABANDONED

Contractor

NE NW NE

SECTION PLAT

			0

330 Ft. from N. Line

Ft. from S. Line

Ft. from E. Line

990 Ft. from W. Line

Rooks County

Location

Rig up

Drilling and Remarks:

Cer 83644

RECORD

Cased _____ in., _____ ft.

Sand _____

Gas _____

Oil _____

Total Depth 3212

PRODUCTION

1st 24 hrs. Nat. _____

1st 24 hrs. after shot _____

Gas _____ Cu. Ft.

Dry Hole _____

Abandoned _____

Date

NOV 22 1944

19

S. J. LEWIS Scout