FORM 51 25M 8-50 WESTERN

Rooks


KANSAS

Section 10 Township 9 Range 19 W

Well No. #6 Rostocil "C"

Company Sohio et al

6

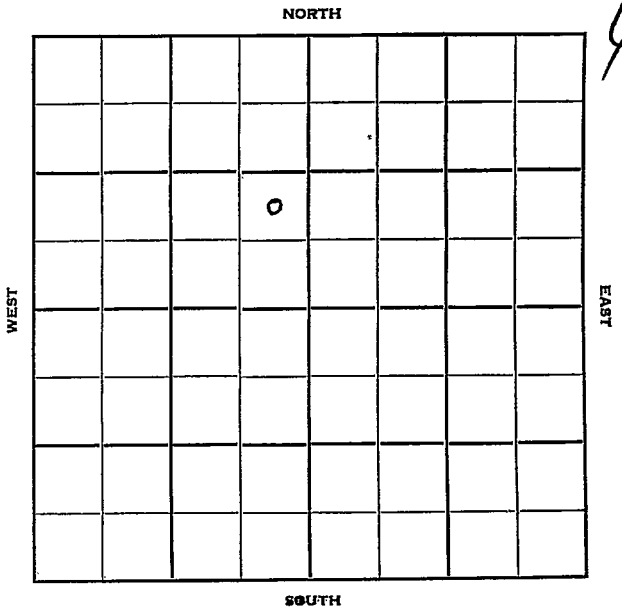

FORM 252-B
10M 11-50 PETROL

Rooks KANSAS

Sec. 10 Twp. 9 R. 19W

Well No. #6 Rostocil "C" Farm

Sohio et al Company

Strain Drlg. -Contr. Contractor


____ Ft. from N. Line

990' Ft. from S. Line

330' Ft. from E. Line

____ Ft. from W. Line

NE SE NW

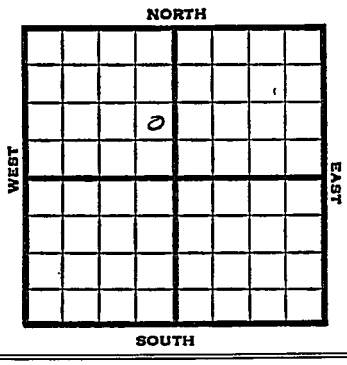

1951	Elev. 2027' REPORT
1/31	RUR
4/18	Spud 2-9-51 SWD well TD 3801' 8" @ 319 Anhy 1437', Heeb 3170' Lans. 3212' DST 3210-35 open 1 hr. rec 390' SW DST 3295-3325 open 1 hr. rec 16' mud DST 3366-95 open 1 hr rec 60' OCM, 60' oil specked mud Arb. 3452-59 TD 3504' 5" @ 3456 SP 3432' 21/3413-18 1000 A S/10 GO 33 GWPH SP 3400' 21/3363-68 21/3371-76 500 A S/1 BOPH S/45 GOPH 1500 A S/2 BOPH SP 3358' 25/3348-54 SO 500 A 25 GO 16 GW PH DC to 3400' Perf/3363-68 3371-76, 3348-54, 25 GO 16 GWPH DD 3595' TD 3801' 170' of 4" liner @ 3511' Comp. for SWD well **ABANDONED**

FORM 275 FOR SALE BY KANSAS BLUE PRINT CO.


County Rooks State Kansas

Sec. 10 (Blk. / Twp.) 9 (Sur. / Rge.) 19W Map No.

Operator Sohio etal

Well No. 6 Farm Rostocil "C"

Elev. Location NE SE NW

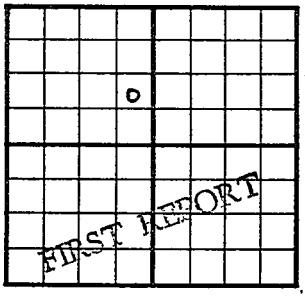

990 Ft. From S Line NW

330 Ft. From E Line Quarter

1st. Report JAN 31 1951

Completion

Remarks

Strain Drlg. - Contr.

Spudding Date

Drlg. Data

R U R

J. E. TYRA

FORM 275 FOR SALE BY KANSAS BLUE PRINT CO.


County Rooks State Kansas

Sec. 10 (Blk. Twp.) 9 (Sur. Rge.) 19W Map No.

Operator Sohio etal.

Well No. 6 Farm Rostocil "C"

Elev. 2027 Location NE SE NW

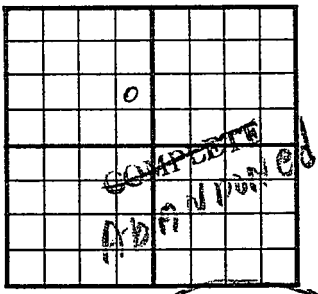

990 Ft. From S Line NW

330 Ft. From E Line Quarter

1st. Report

Completion APR 18 1951

Remarks APR 14 '51
Strain Drlg. - Contr.

Spudding Date 2-9-51

Drlg. Data SWD well TD 3801

8" @ 319 Anhy 1437 Heeb. 3170

Lans. 3212 DST 3210-35 open 1 hr.

Rec. 390' sw DST 3295-3325 open 1 hr.

Rec. 16' mud DST 3366-95 open 1 hr.
Rec. 60' ocm 60' oil specked mud

Arb. 3452-59 TD 3504 5" @ 3456

SP 3432 21/ 3413-18 1000 A S/ 10 go
33 gwph SP 3400 21/ 3363-68 21/ 3371-
76 500 A S/ 1 boph S/ 45 goph 1500 A
S/ 2 boph SP 3358 25/ 3348-54 SO 500A
25 go 16 gwph DC to 3400 Perf/ 3363-68
3371-76 3348-54 25 go 16 gwph

DD 3595 TD 3801 170' of 4" liner @ 3511
Comp. for SWD well

J. E. TYRA